


T. 18S. R. 8W.W.M.

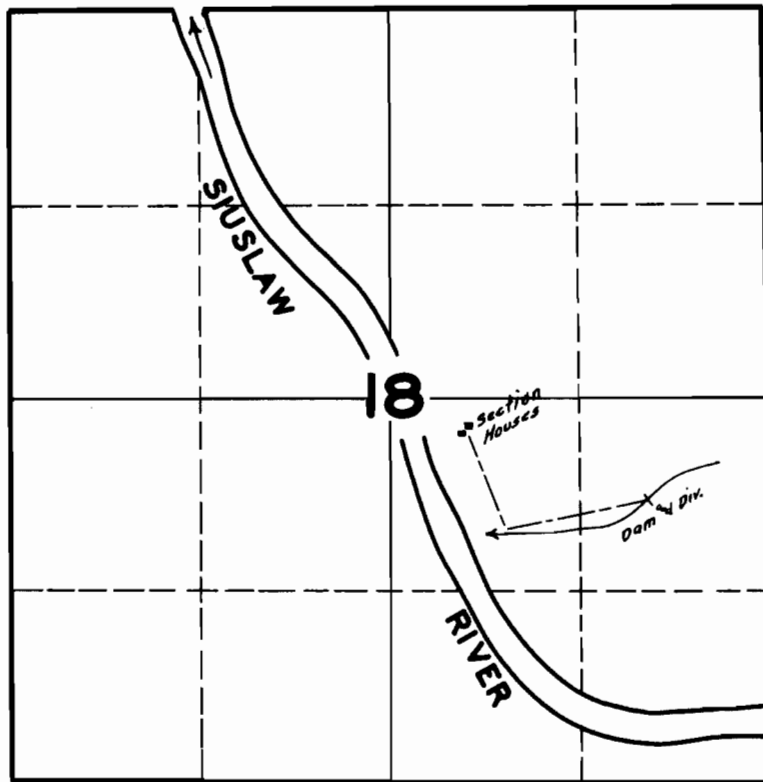

**FINAL PROOF SURVEY**  
UNDER

Application No. 20580 Permit No. 16082

IN NAME OF  
SOUTHERN PACIFIC COMPANY

Surveyed AUG. 6 1946, by [Signature]