


# T. 7S. R. 1W. W.M.

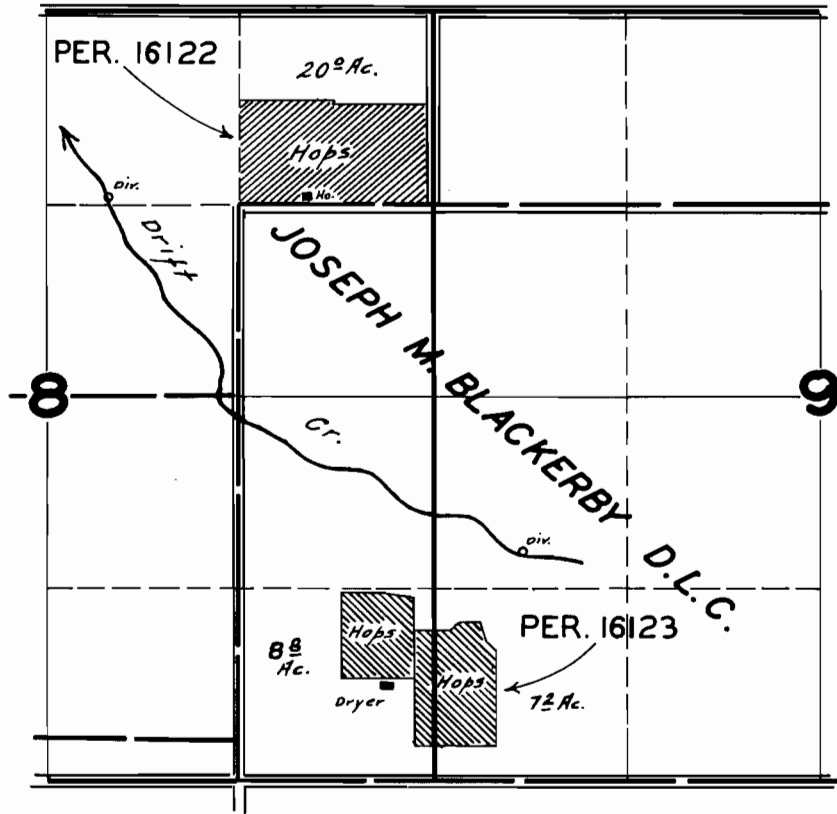

## FINAL PROOF SURVEY

UNDER  
20604                      16122  
Application No. 20605    Permit No. 16123

IN NAME OF  
H.A. KUENZI

Surveyed MAY 10, 1946, by *[Signature]*