


T. 7S. R. 1W. W.M.

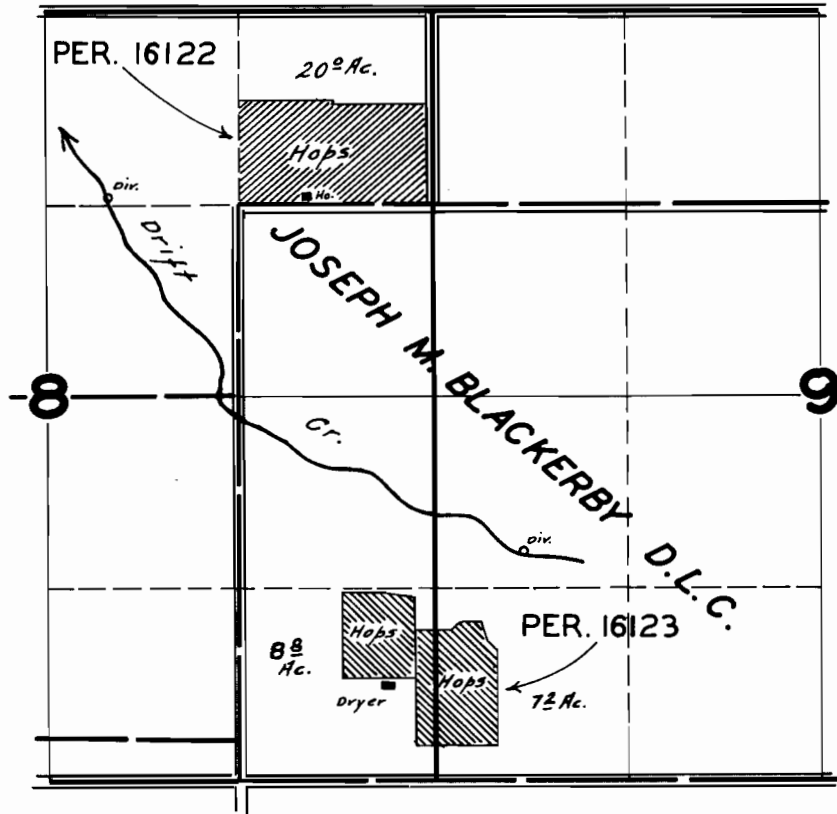

FINAL PROOF SURVEY

UNDER

20604

16122

Application No. 20605 Permit No. 16123

IN NAME OF

H.A. KUENZI

Surveyed MAY 10 1946, by

[Handwritten signature]