


# T.14S. R. 2W.W.M.

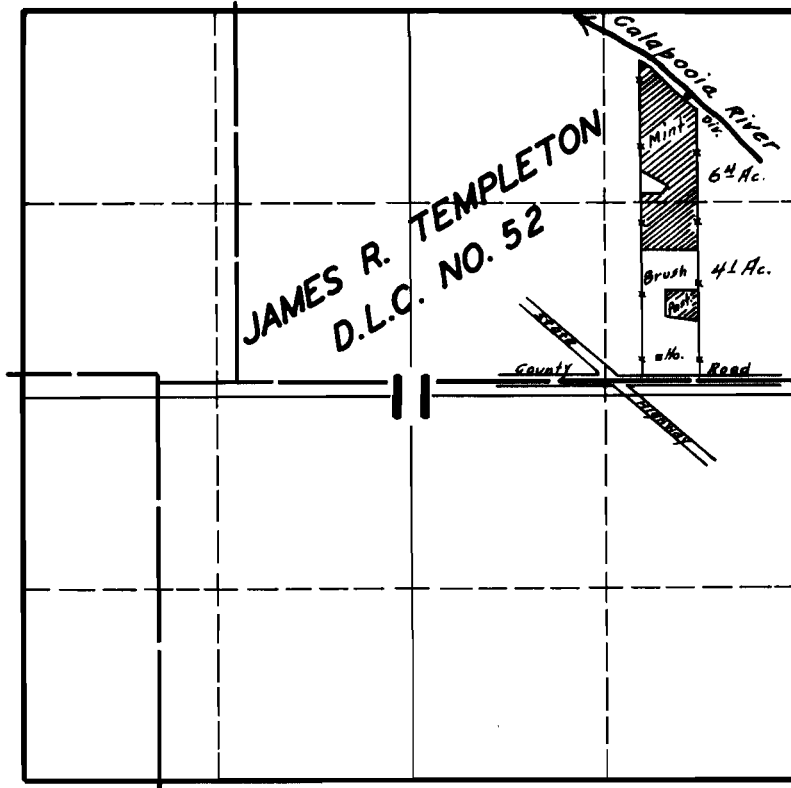

## FINAL PROOF SURVEY UNDER

Application No. 20688 Permit No. 16184

IN NAME OF

J.R. CAIRNES & MRS. J.R. CAIRNES

Surveyed MAY 9, 1946, by *J. R. Cairnes*