


T.3S.R.1W.W.M.

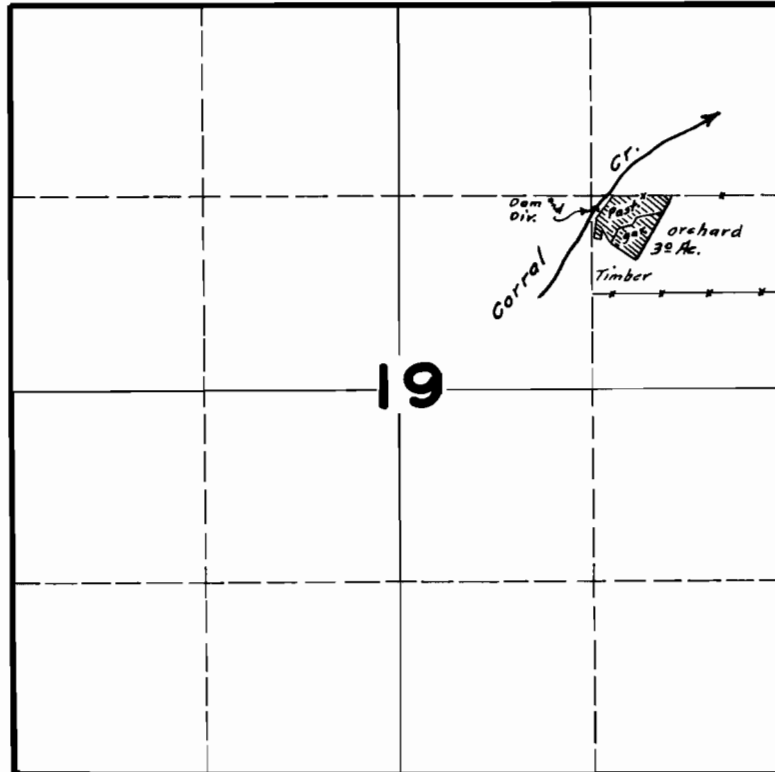

**FINAL PROOF SURVEY
UNDER**

Application No. 20740 Permit No. 16232

IN NAME OF

HERMAN VIELMETTI

Surveyed JUNE 24 1946, by *[Signature]*