T. 1S. R. 4W. W.M.

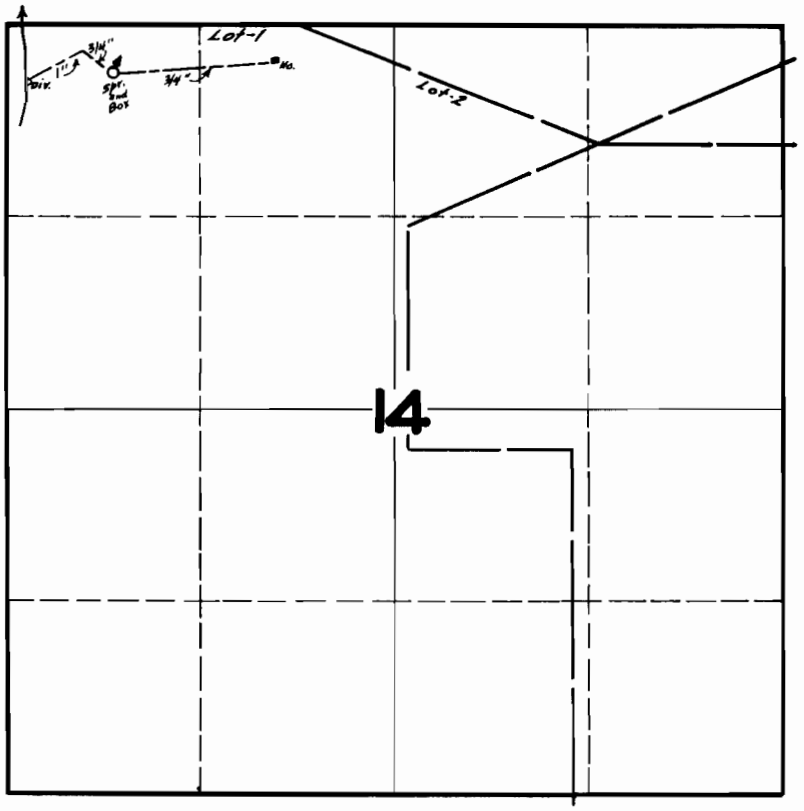

FINAL PROOF SURVEY

UNDER

Application No. 20750 Permit No. 16240

IN NAME OF

CHARLOTTE LAUGHLIN

Surveyed AUG. 23 1945 by [illegible]

1945 - D