


T. 2S. R. 1E. W. M.

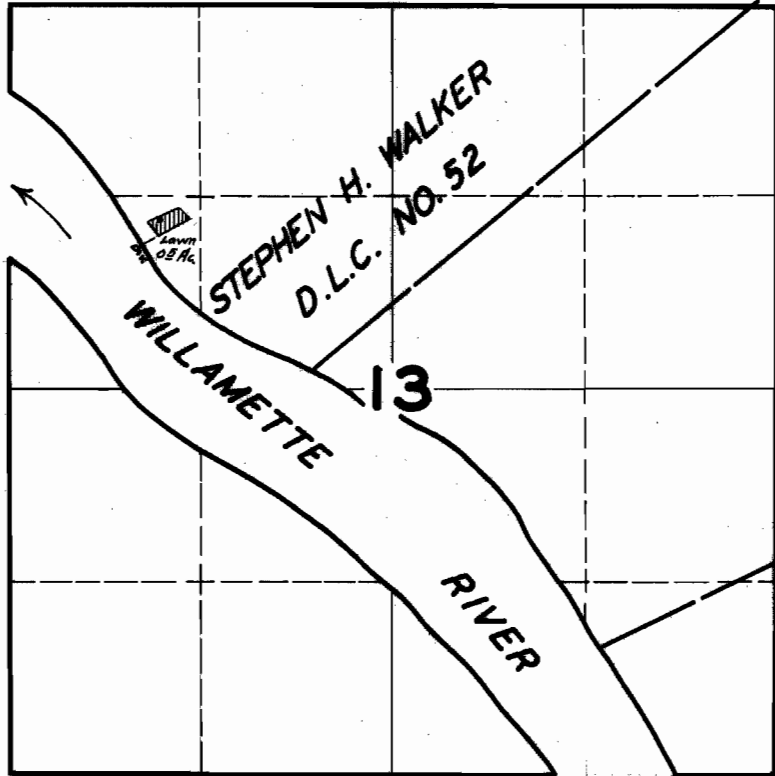

**FINAL PROOF SURVEY
UNDER**

Application No. 20817 Permit No. 16290

IN NAME OF
REX CHILDS

Surveyed JUNE 13 1946 by [Signature]