


T. 2S. R. 1E. W. M.

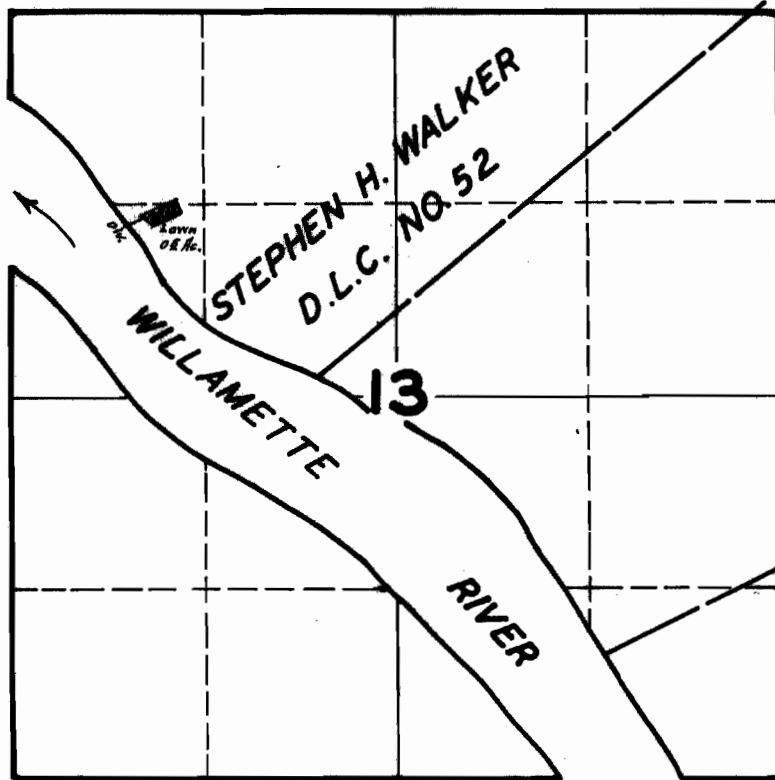

FINAL PROOF SURVEY UNDER

Application No. 20835 Permit No. 16302

IN NAME OF

C. N. APPELGREN

Surveyed AUG. 23 1946, by