


T.12S. R.5W.W.M.

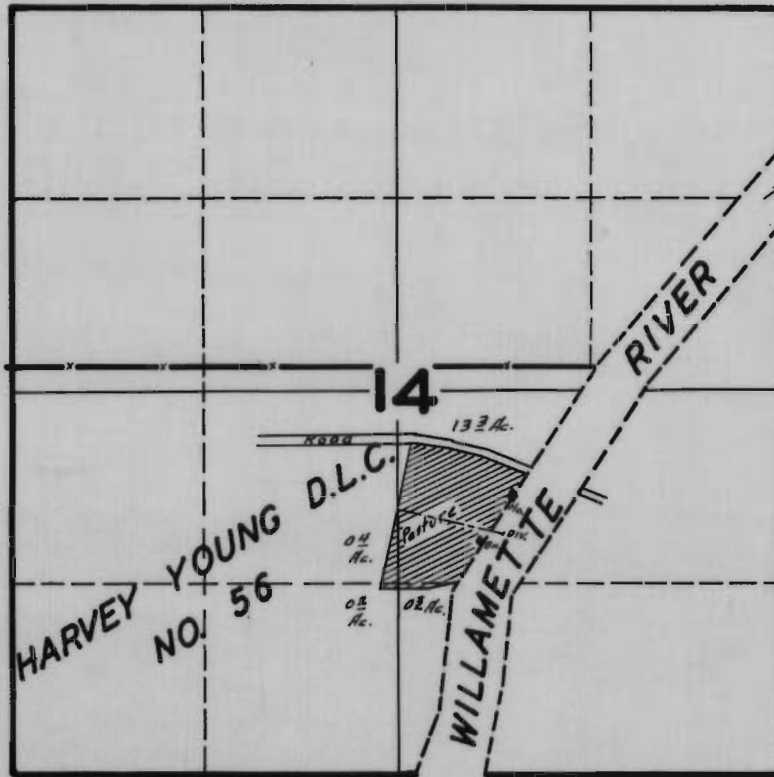

**FINAL PROOF SURVEY**  
UNDER

Application No. 20836 Permit No. 16303

IN NAME OF

IVAN CHORACK

Surveyed JULY 16 1946 by [Signature]