


SECTION

10

TOWNSHIP 35S, RANGE 1W, W. M.

North

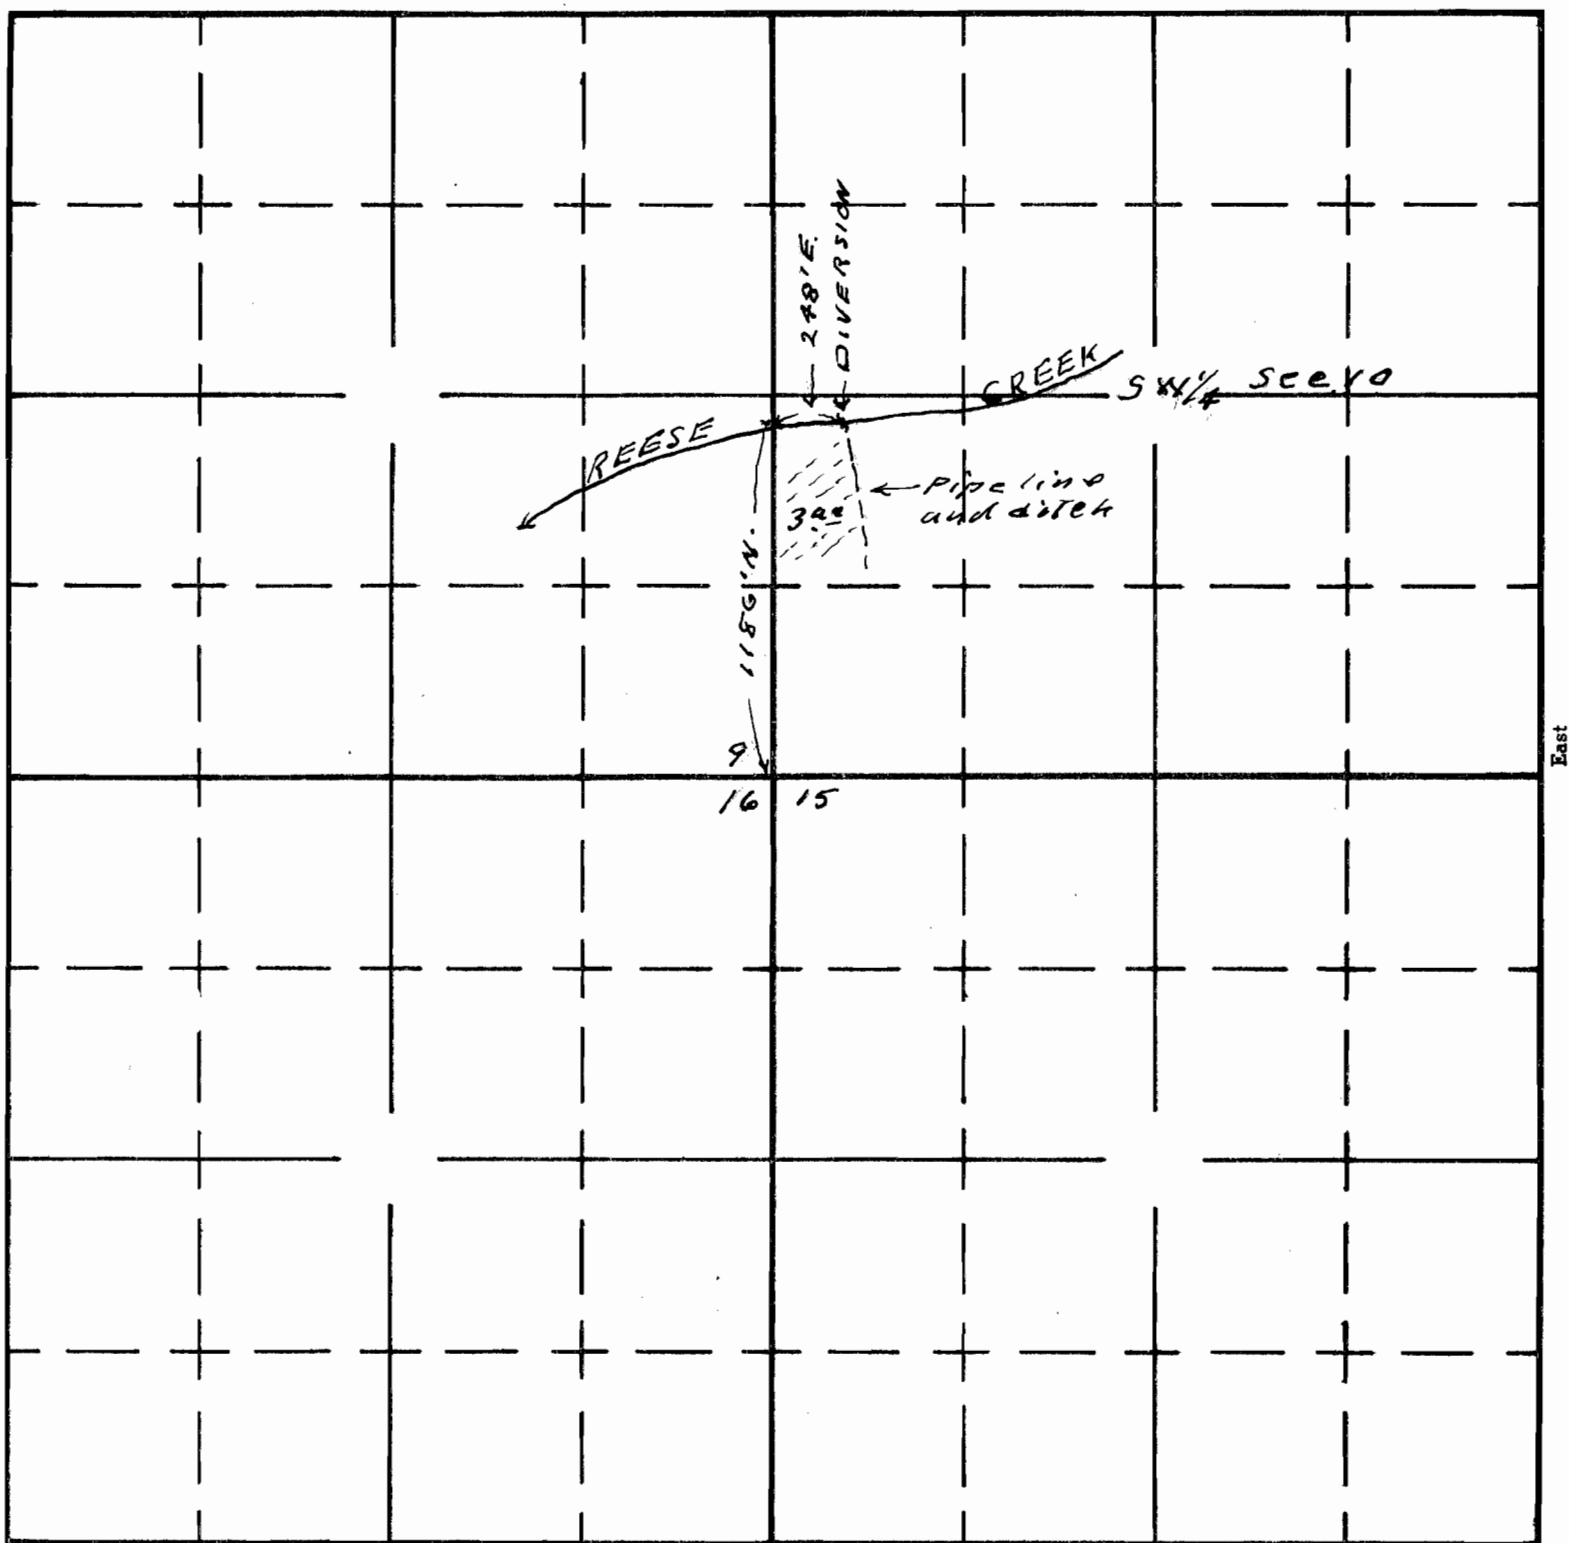

South

20860
15-780

Map To accompany application of Edward R Moxley for use of waters of Reese Creek for irrigation purposes

Application No. 20860

Permit No. 16337

This office 5/8/18