


T.2S.R.2E.W.M.

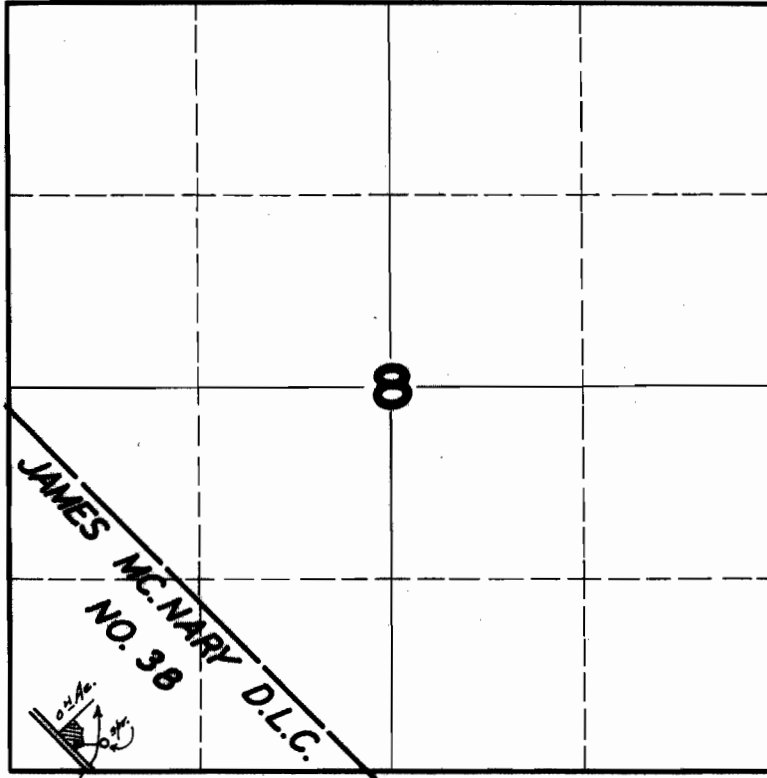

FINAL PROOF SURVEY
UNDER

Application No. 20875 Permit No. 16349

IN NAME OF

CHARLES SMITH

Surveyed JUNE 11 1946 by