


T.16S.R.7W.W.M.

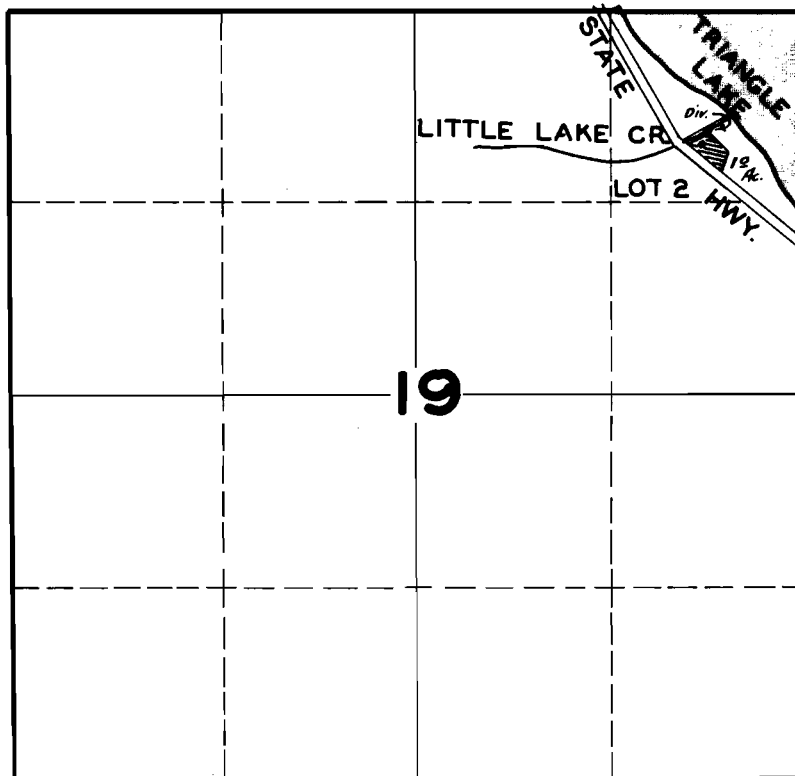

FINAL PROOF SURVEY

Application No. 23308
Permit No. 16489

UNDER
23308 18382
Application No. 21044 Permit No. 16489

IN NAME OF

MRS. ETHEL HABERLAND

Surveyed AUG. 11 1947, by JAS. E. BUNNELL