


T.2S. R.2E.W.M.

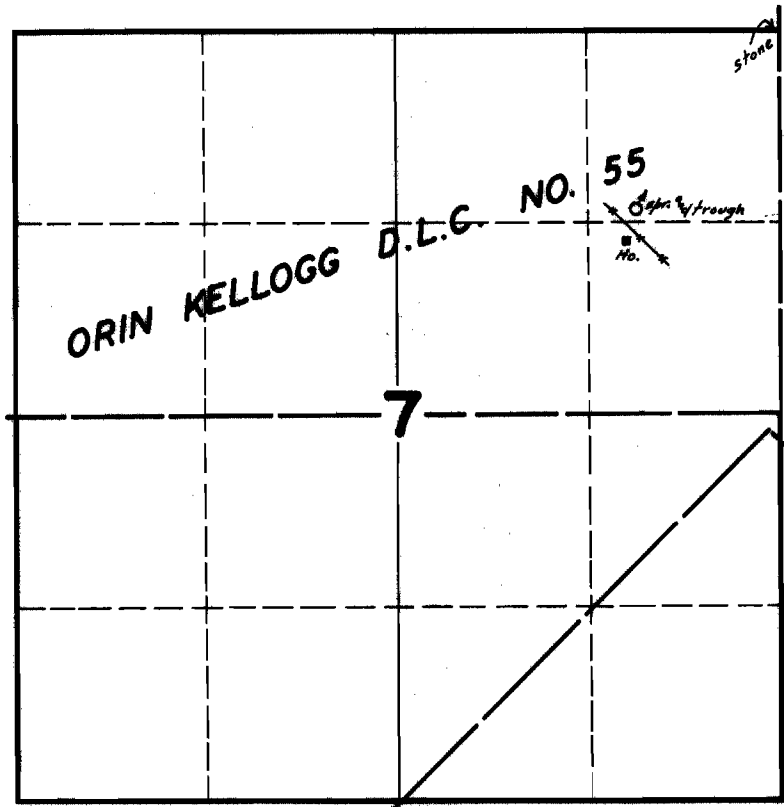

FINAL PROOF SURVEY
UNDER

Application No. 21099 Permit No. 16534

IN NAME OF

MINERVA D. THIESSEN

Surveyed JUNE 11, 1946, by James Sumrell