




,

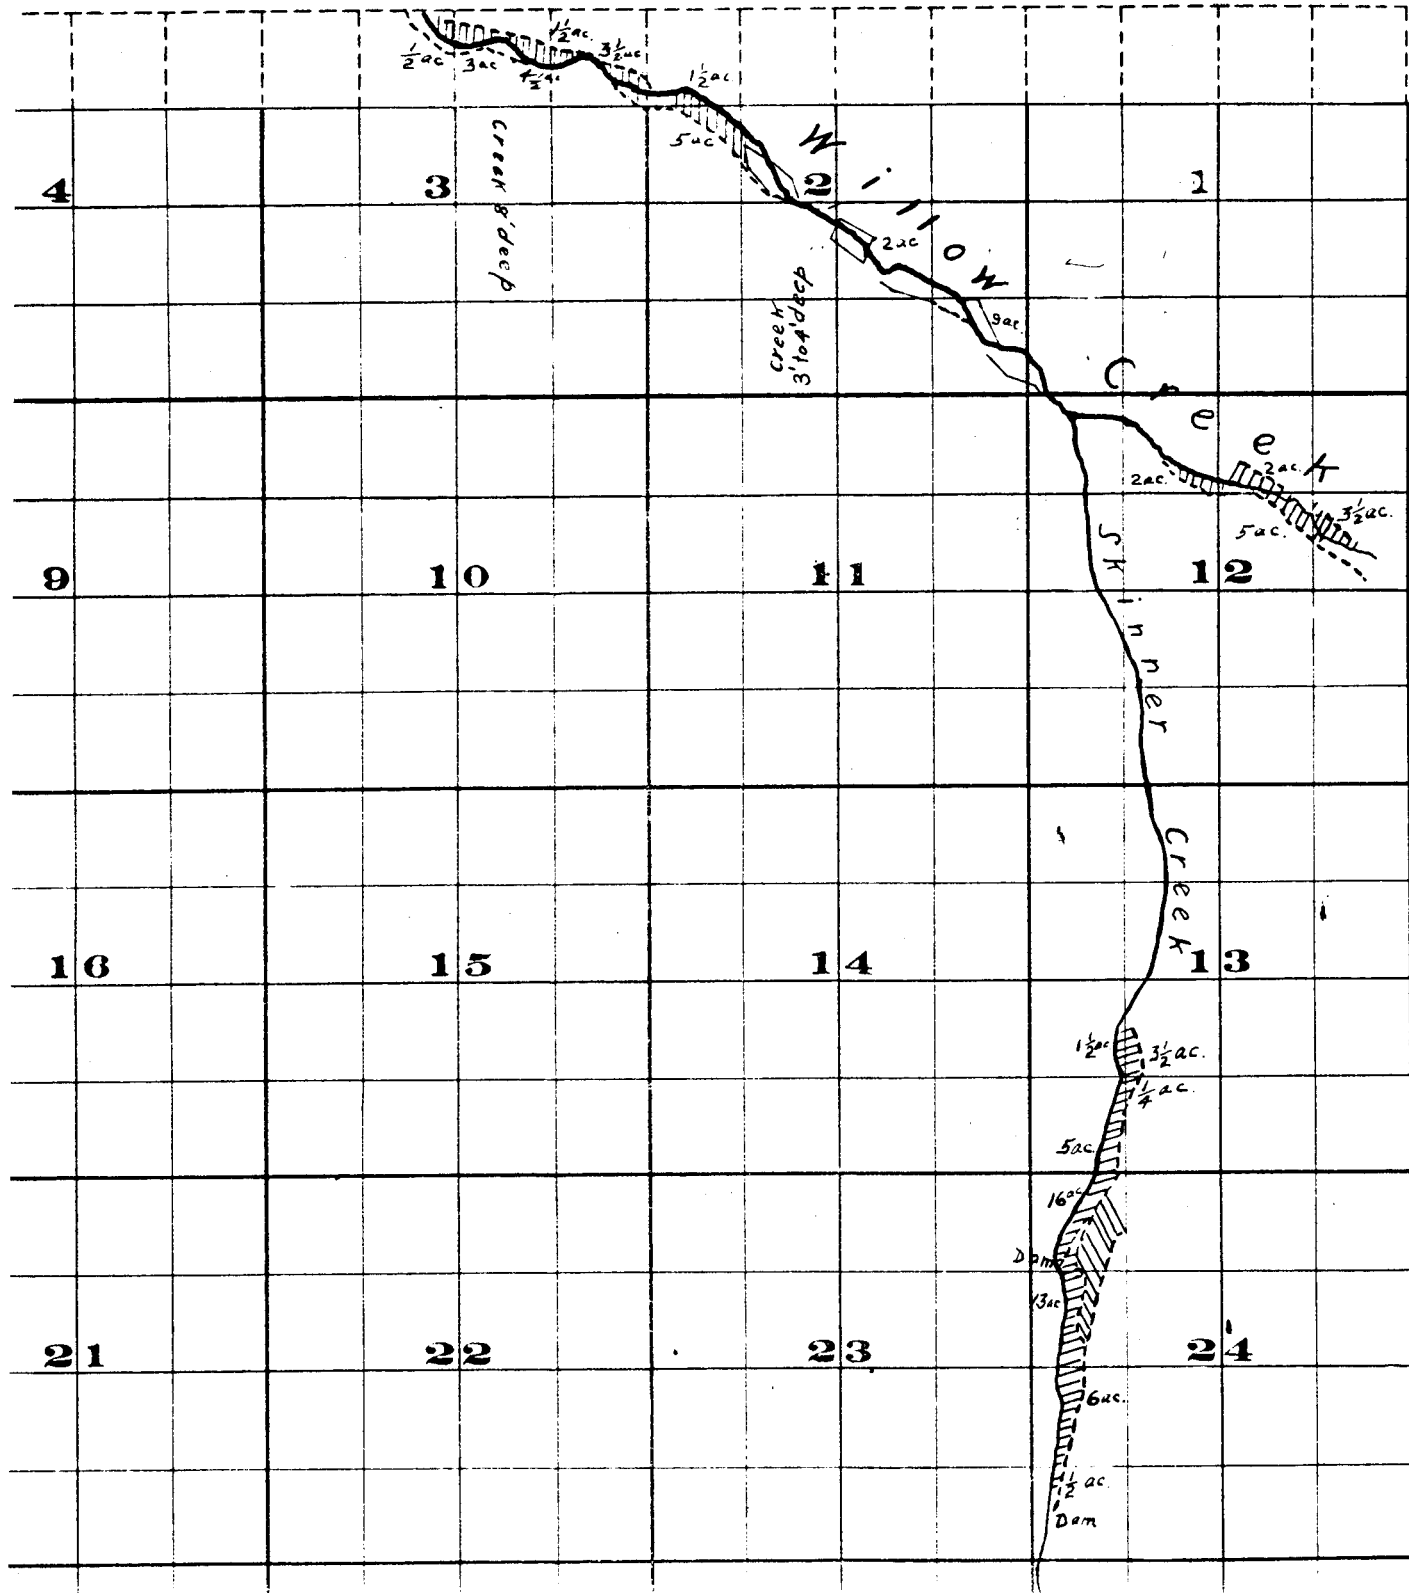

Township 35


,

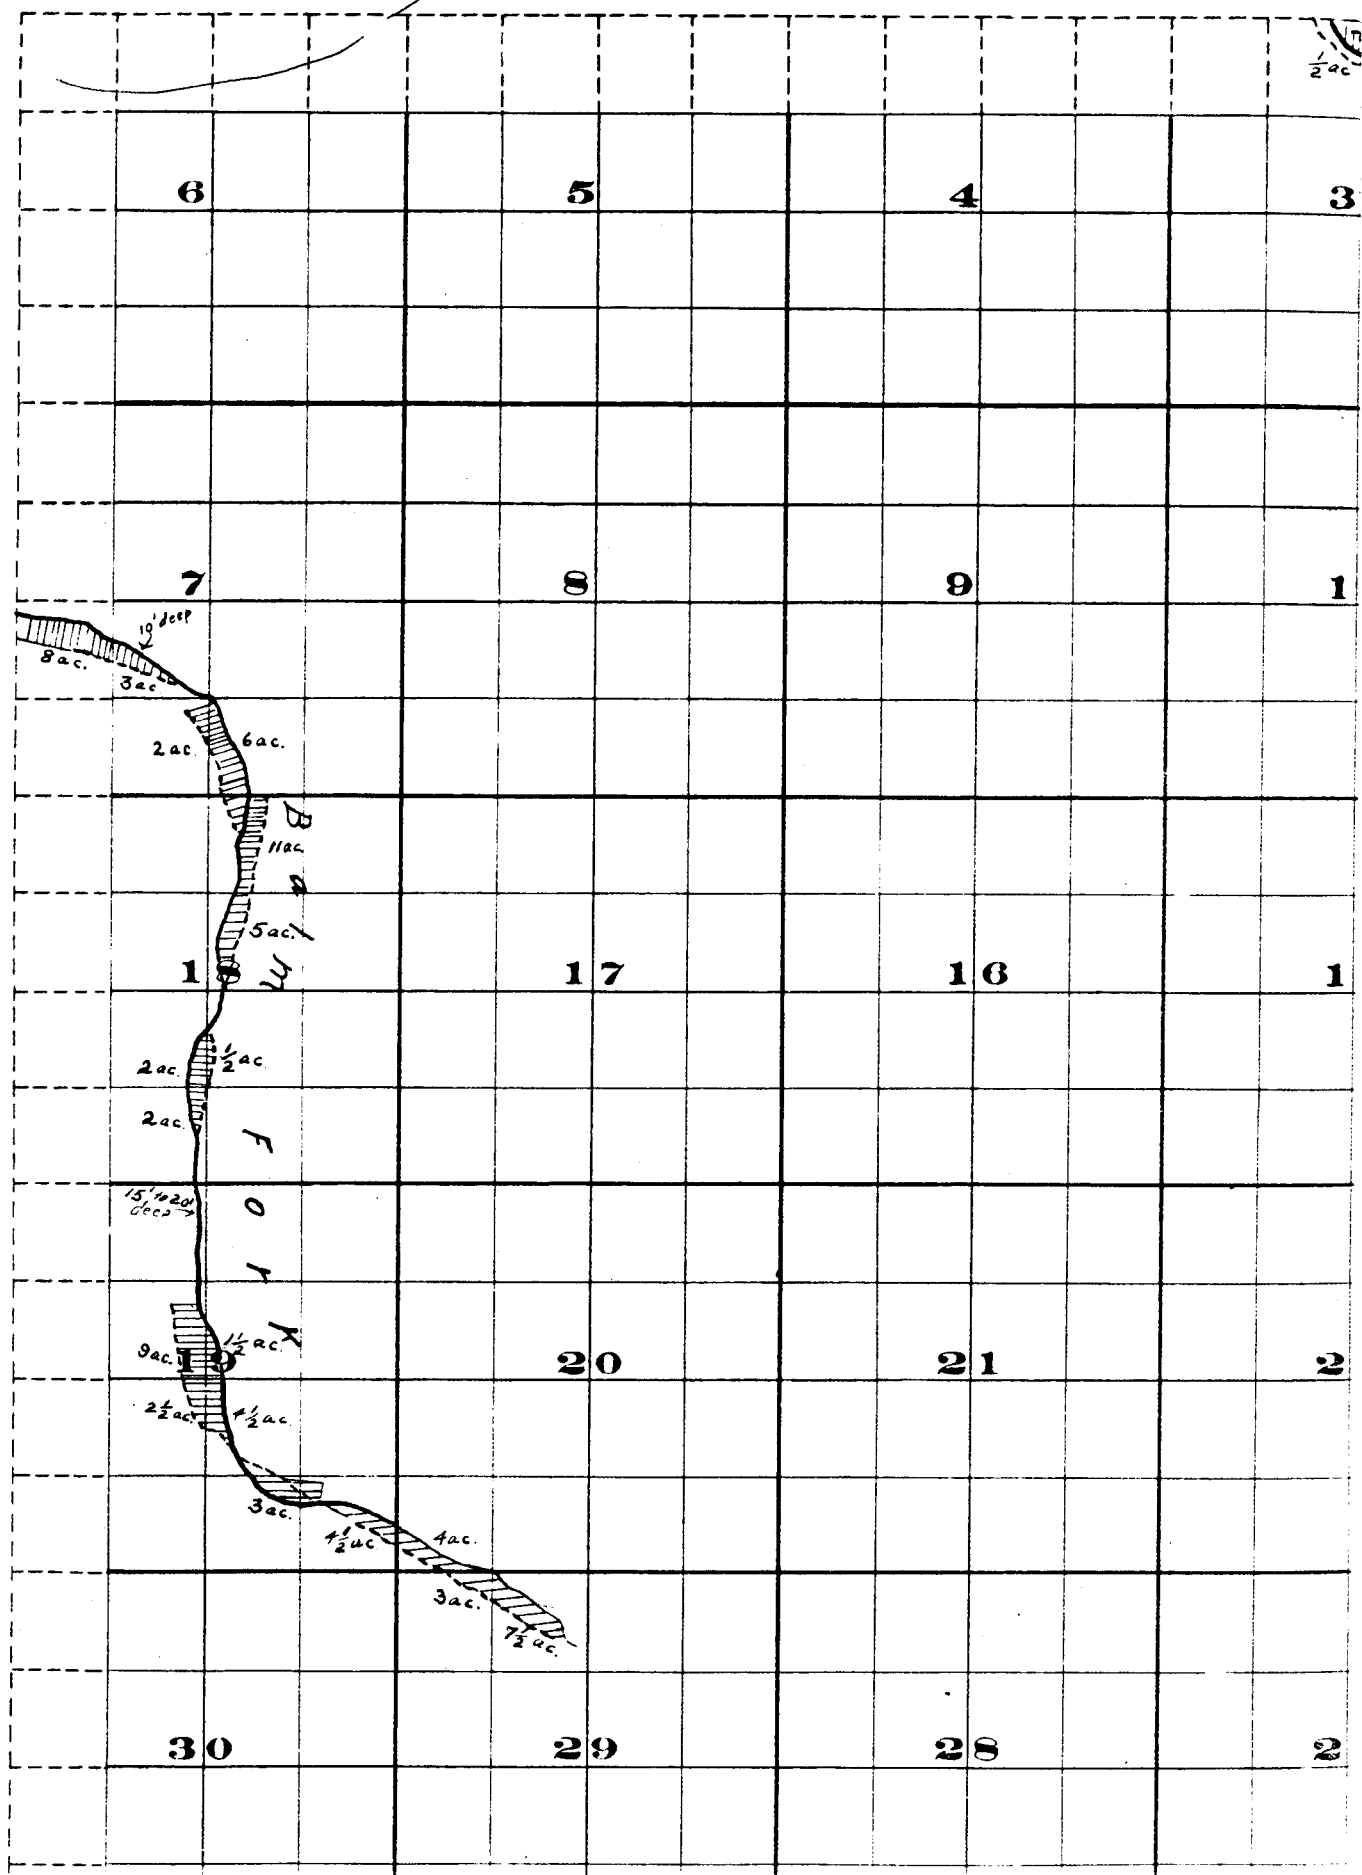

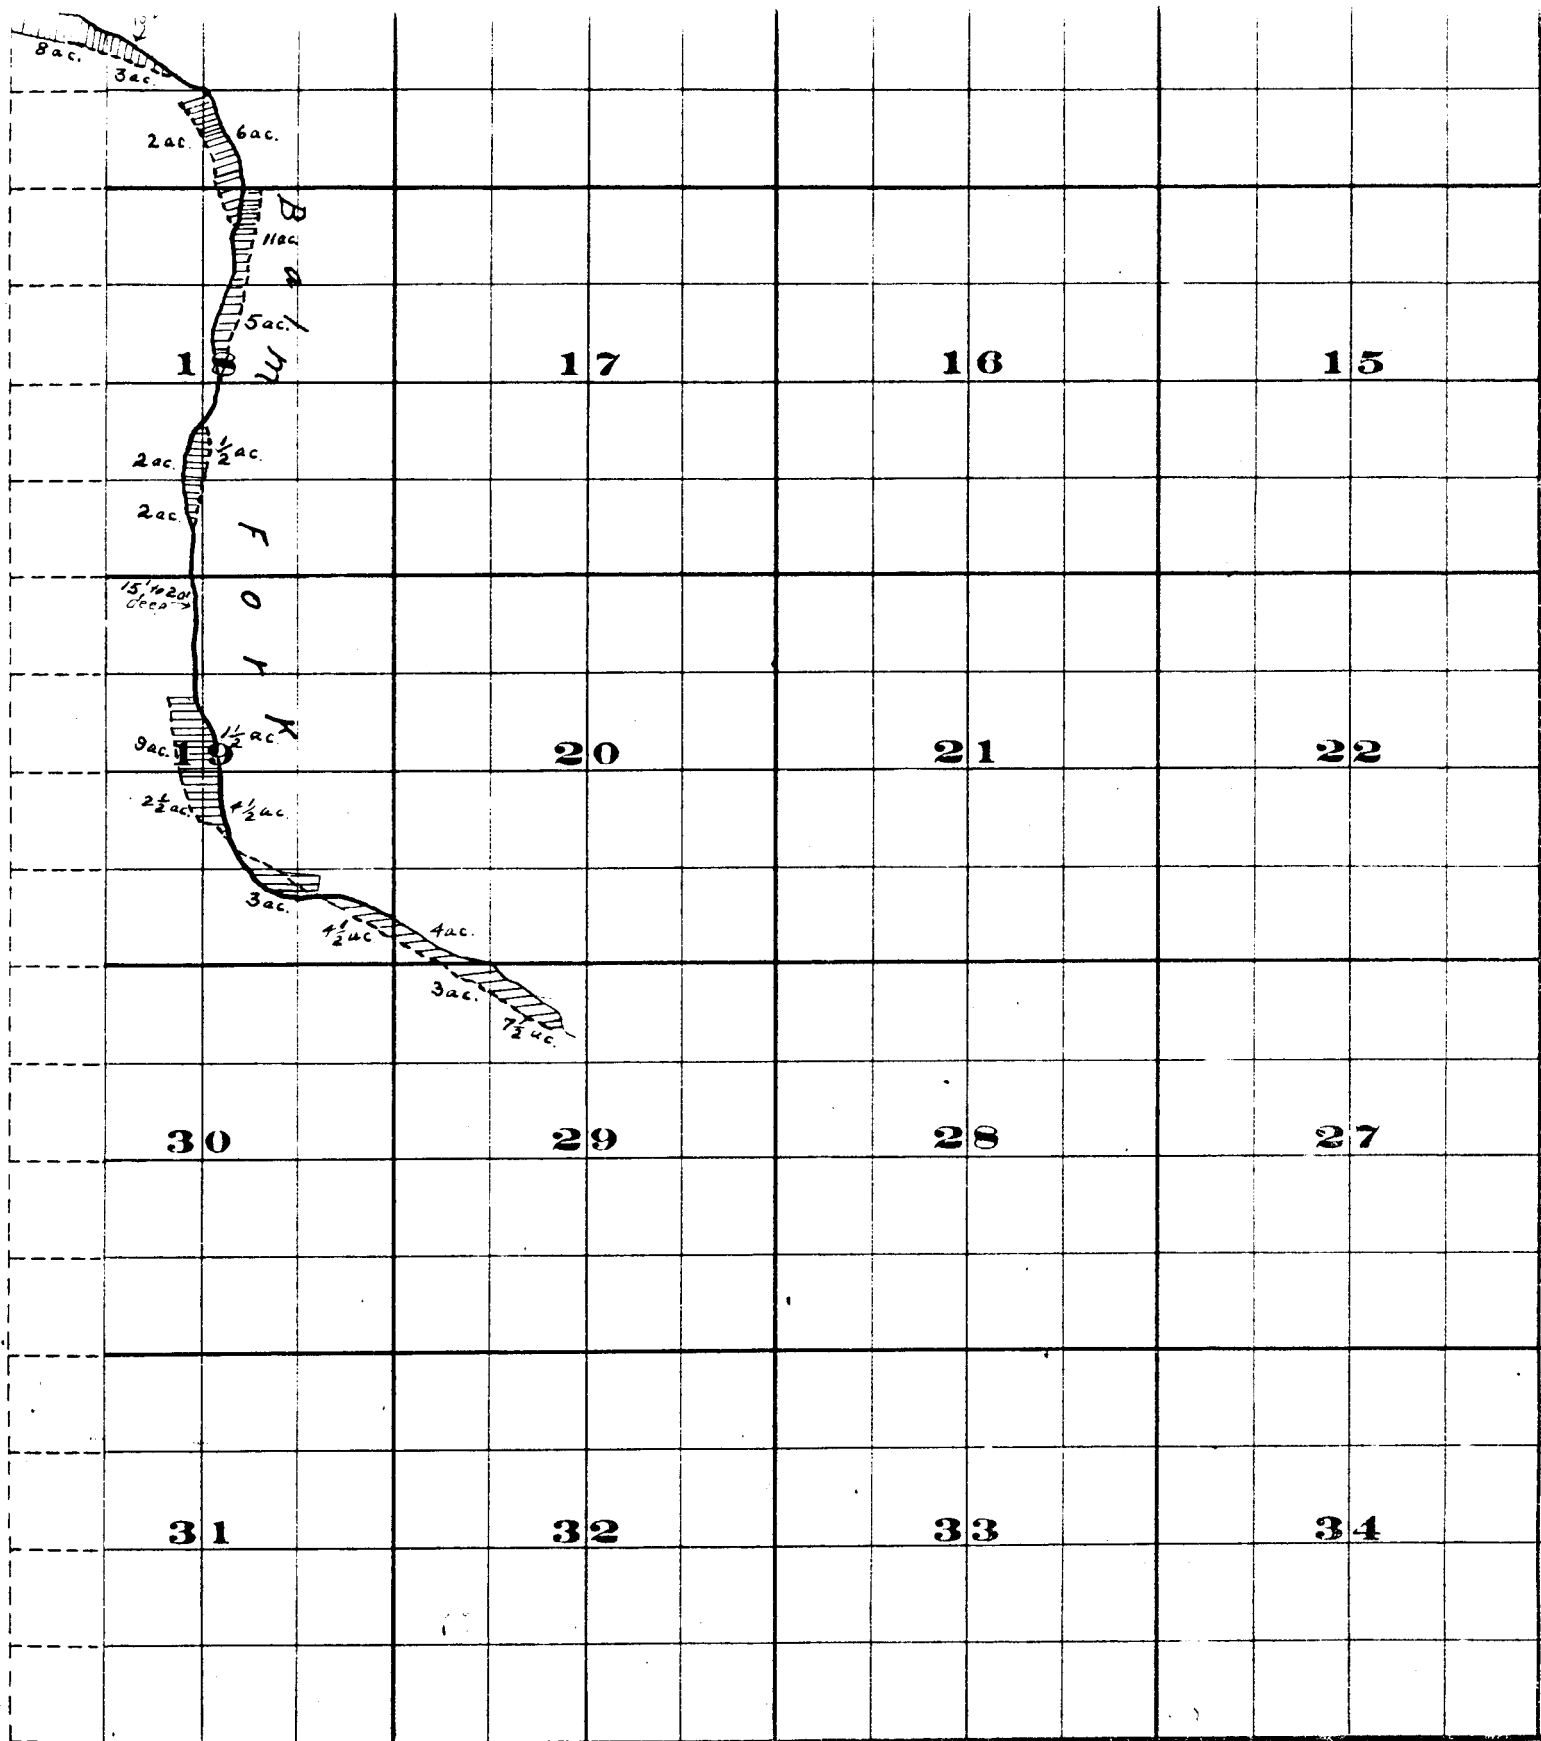

THE BRISTOL CO. PRINTERS & BOOKBINDERS (INCORPORATED)

Surveyed by H.K. Donnelly July 1909
 Surveyed by R.D. Cooper July 1909
 John H. Lewis - State Engineer
 Examined, July 14, 1909.

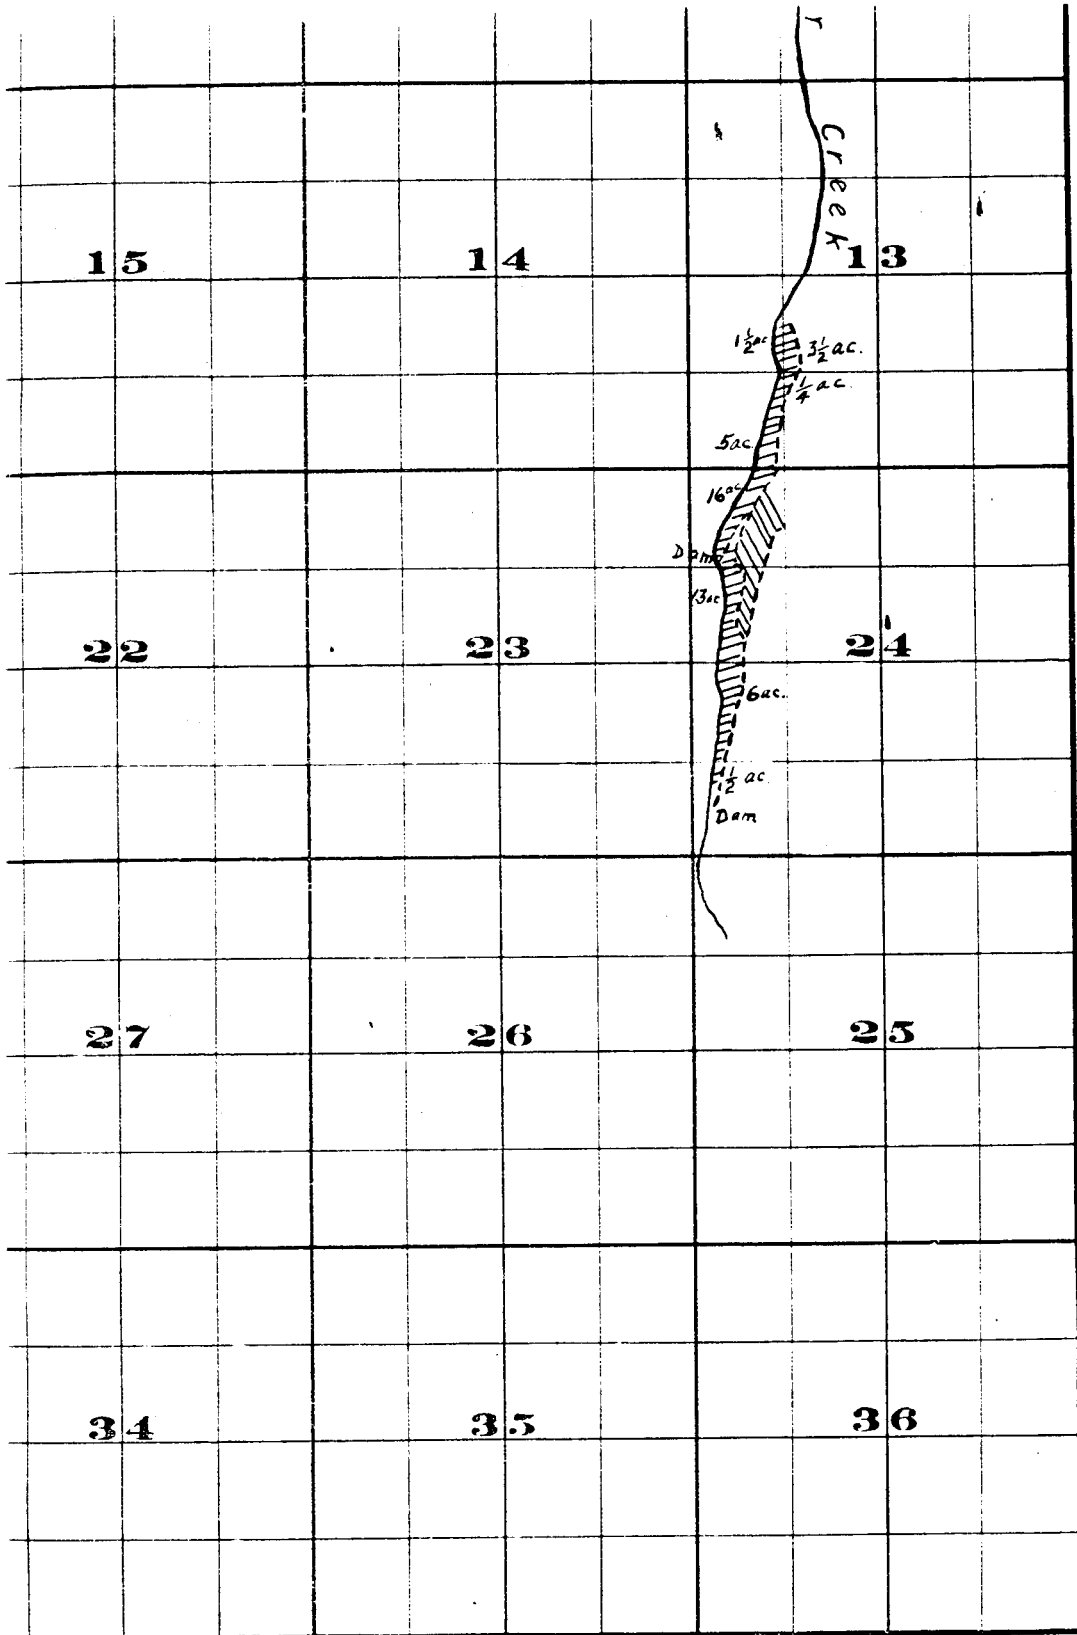

FROM OFFICE OF THE STATE ENGINEER, SALEM, OREGON


Willow Creek Adjudication


35.27 E.

,

[illegible]

Township 2 S.

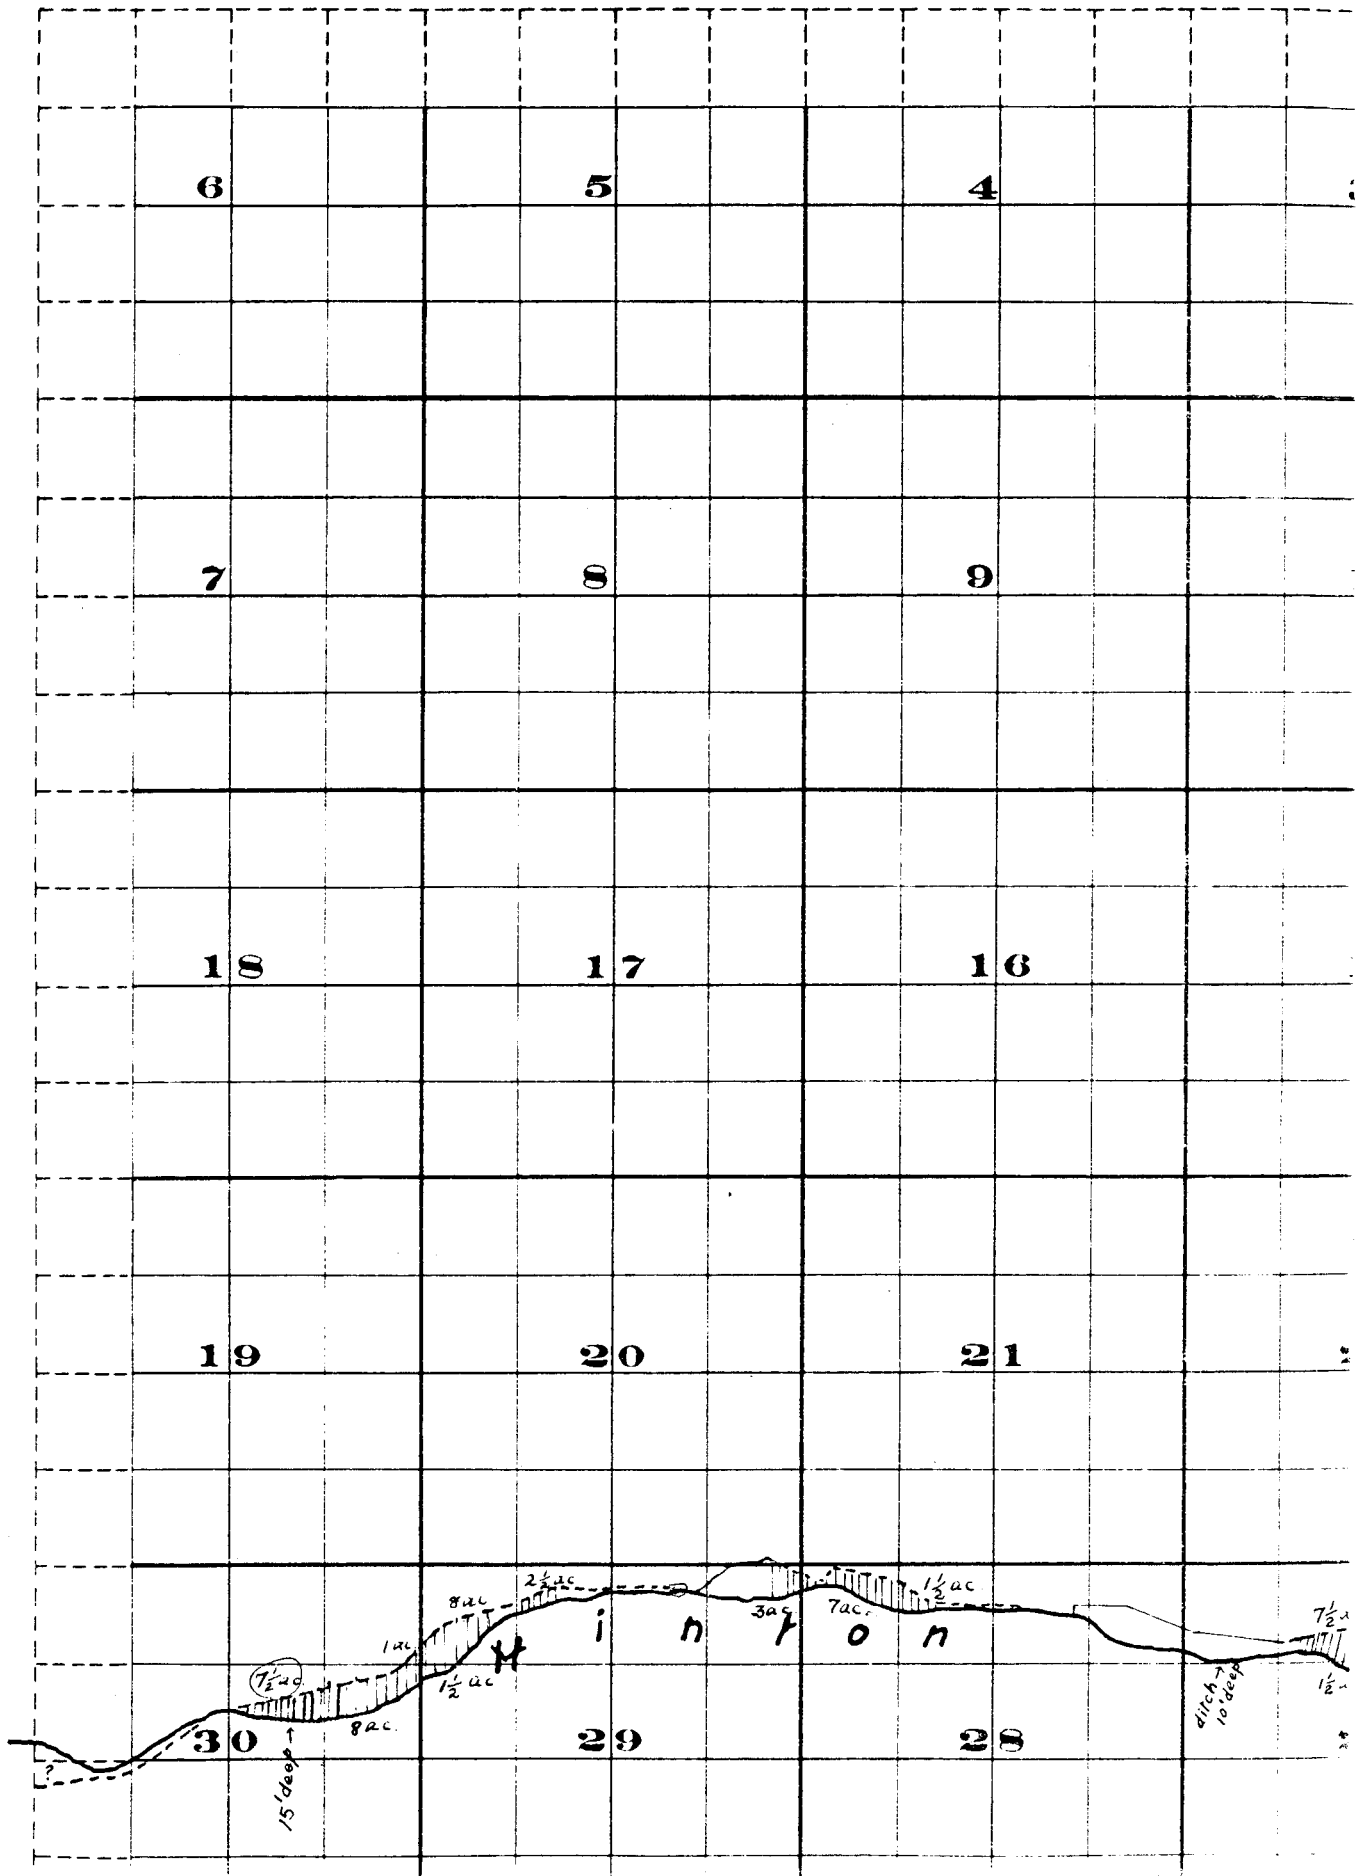

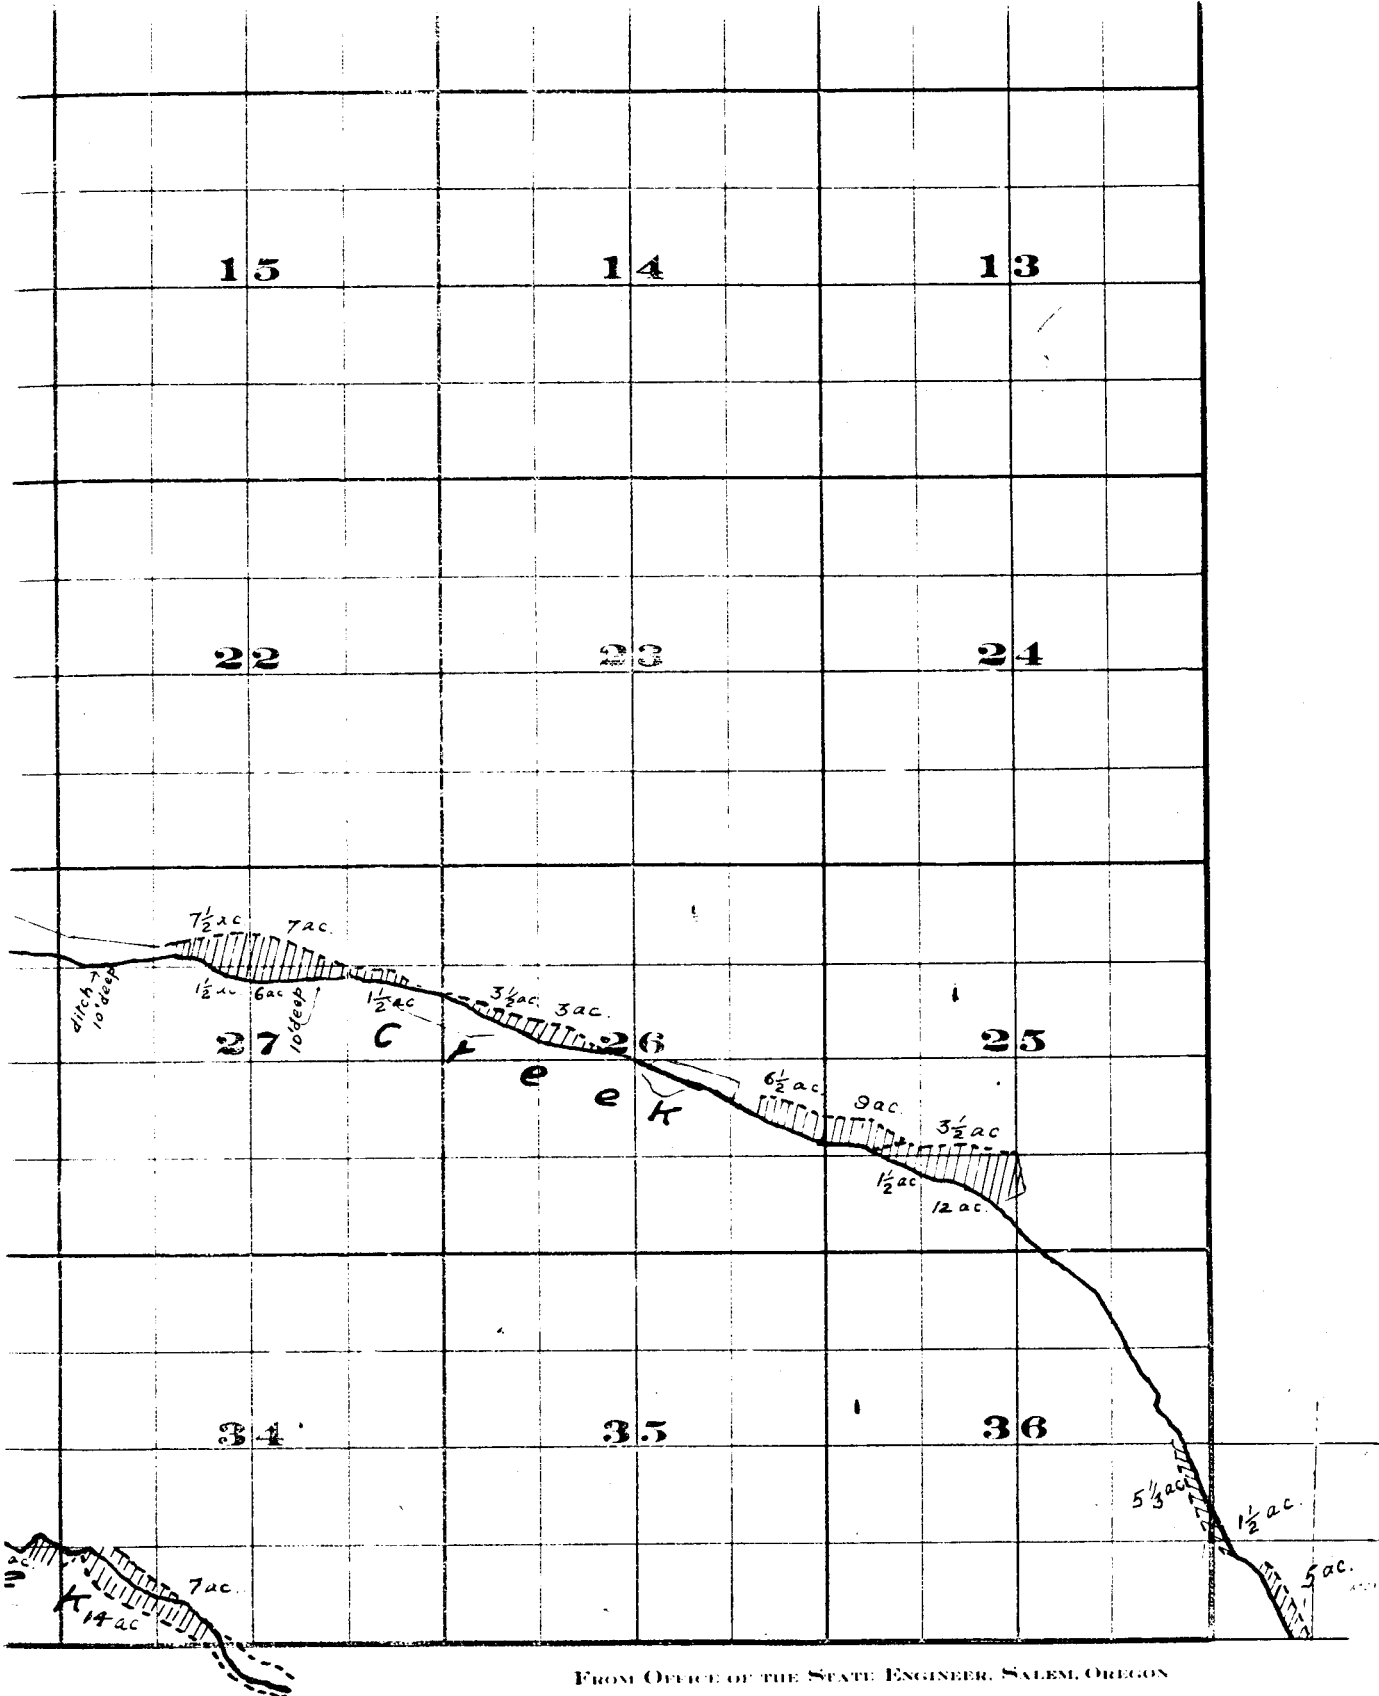

31

per July 1909
State Engineer

Willow Creek Adjudication

2 S. 27 E
Part 2 S. 28 E
Part 3 S. 27 E