


T.20S.R.46E.W.M.

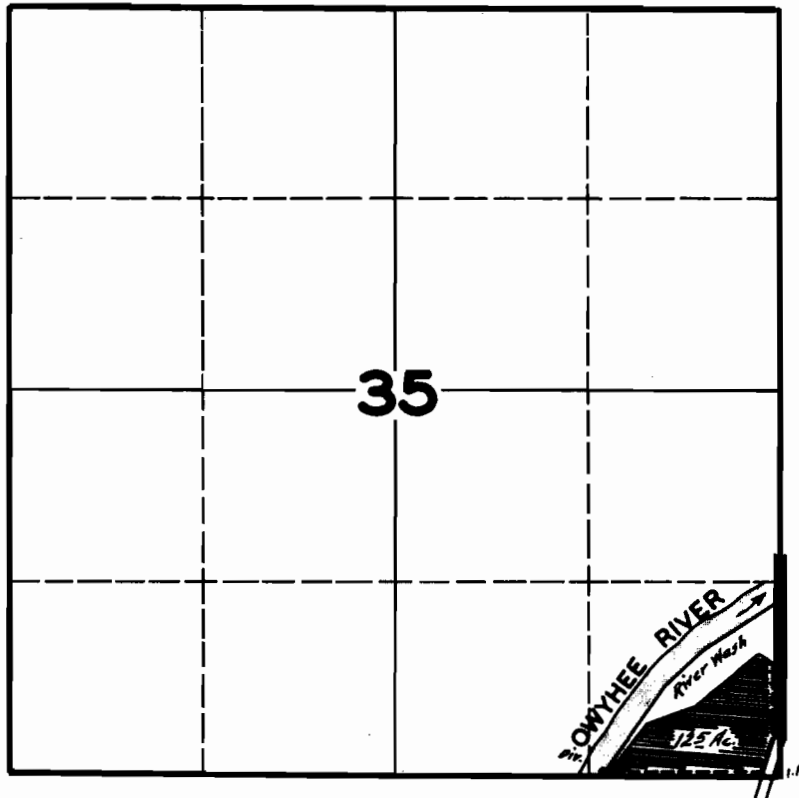

FINAL PROOF SURVEY
UNDER

Application No. 21187 Permit No. 16605

IN NAME OF

ELEANOR MCEWEN

Surveyed MAY 29 1946, by

Handwritten signature of the surveyor, likely J. C. Russell.