


T.18S.R.8W.W.M.

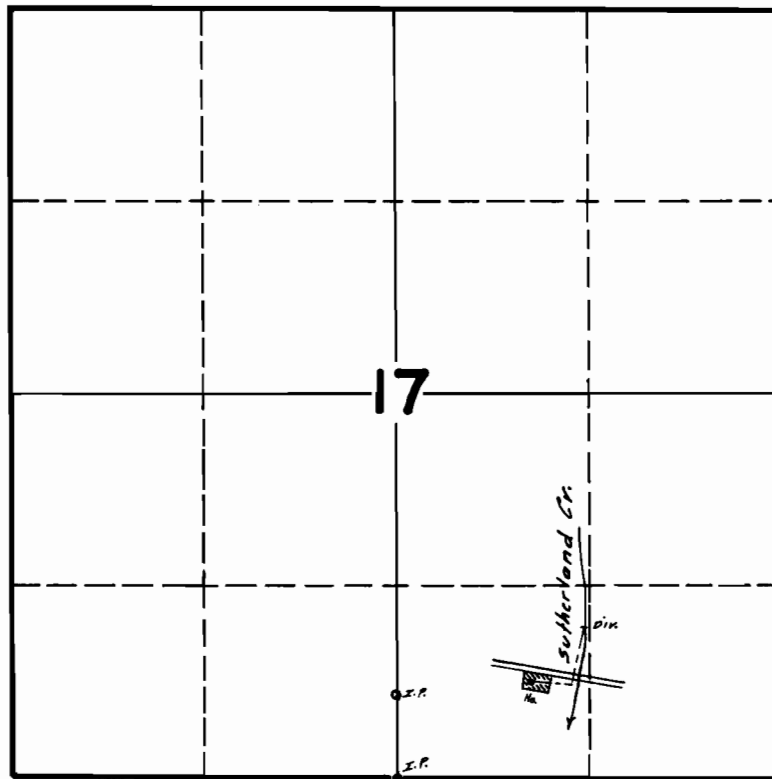

FINAL PROOF SURVEY
UNDER

Application No. 21245 Permit No. 16651

IN NAME OF

WILLIAM S. SUTHERLAND

Surveyed AUG. 6, 1946, by James C. Sumrell