


# T.3S.R.10W.W.M.

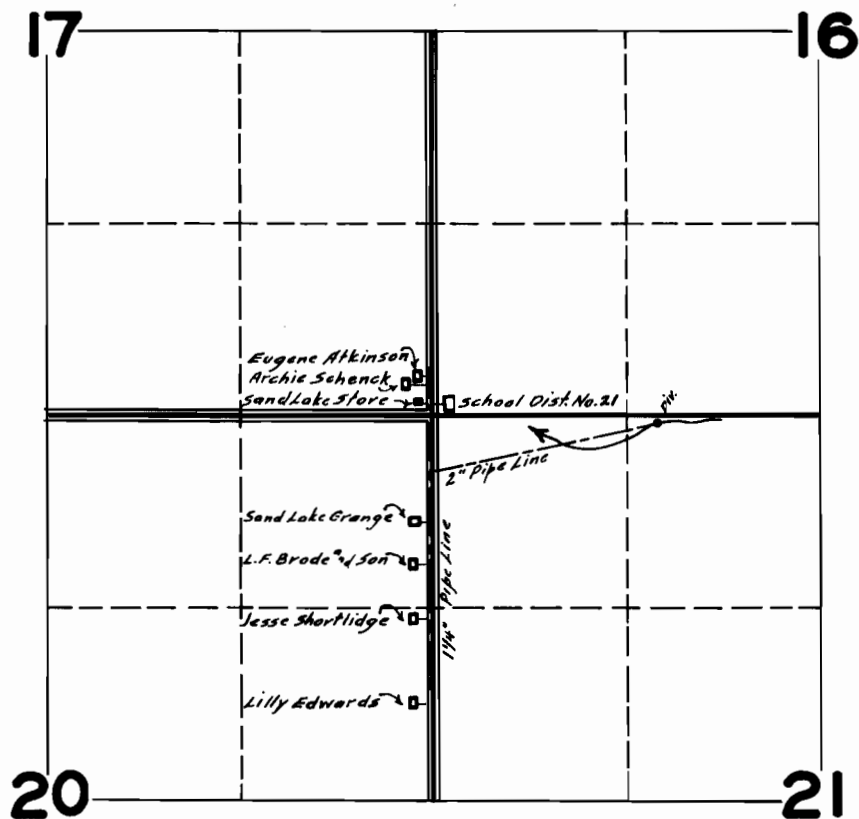

## FINAL PROOF SURVEY UNDER

Application No. 21271 Permit No. 16668

IN NAME OF

JESSE SHORTLIDGE - EUGENE ATKINSON - L.F. BRODE & SON -  
SAND LAKE GRANGE NO. 546 - SAND LAKE STORE SCHOOL DISTRICT NO. 21

Surveyed JULY 17, 1946, by *[Signature]*