


T. 8S. R. 6W. W. M.

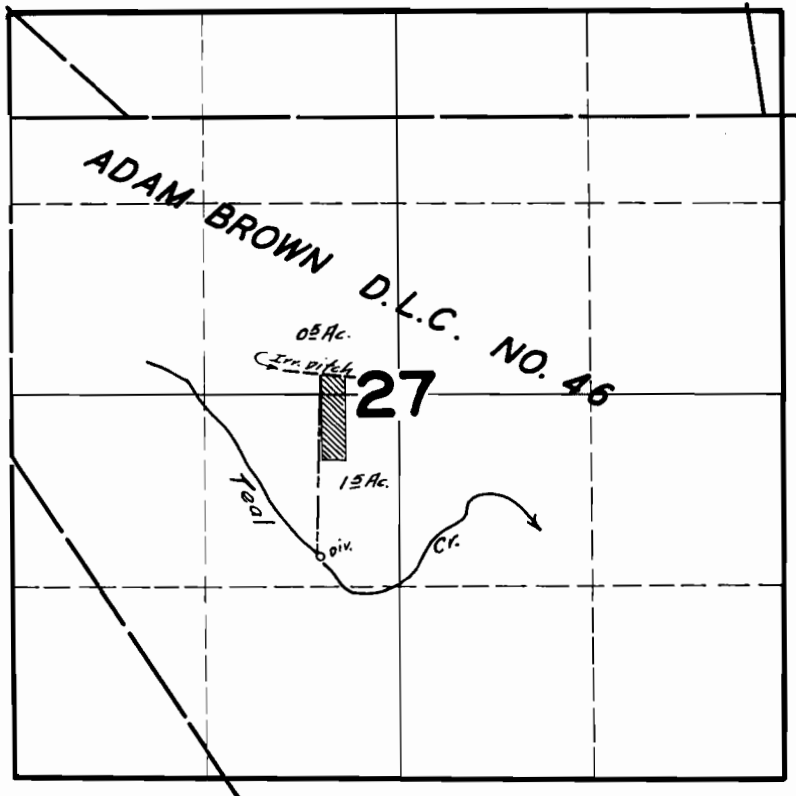

**FINAL PROOF SURVEY**  
UNDER

Application No. 21243 Permit No. 16686

IN NAME OF

GEO. E. MACGINITIE

Surveyed MAY 7, 1946, by [Signature]