


T.5S.R.3E.W.M.

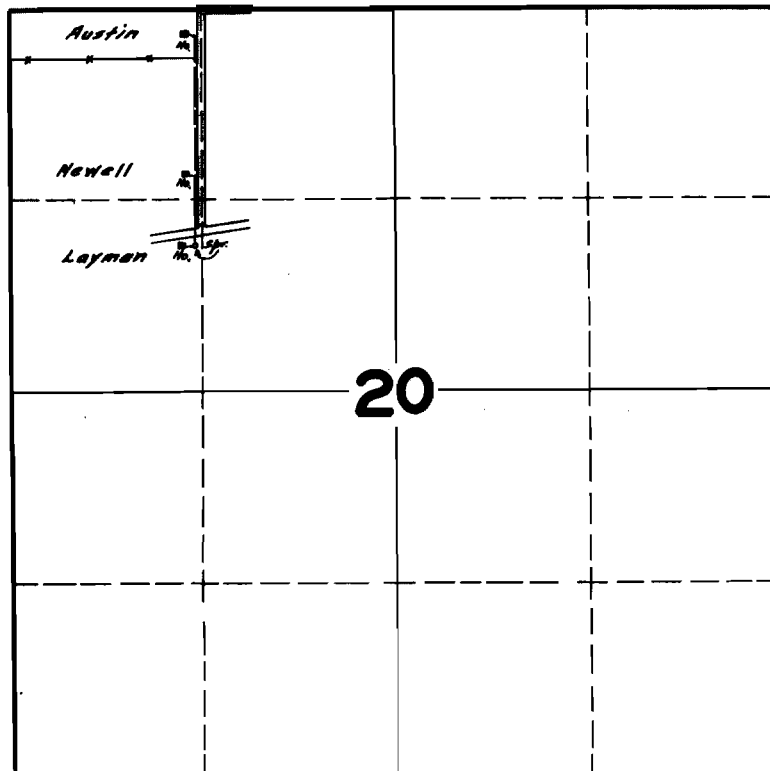

**FINAL PROOF SURVEY
UNDER**

Application No. 21294 Permit No. 16697

IN NAME OF

MERWYN J. NEWELL

Surveyed JUNE 19 1946, by [Signature]