


T.2S.R.IW.W.M.

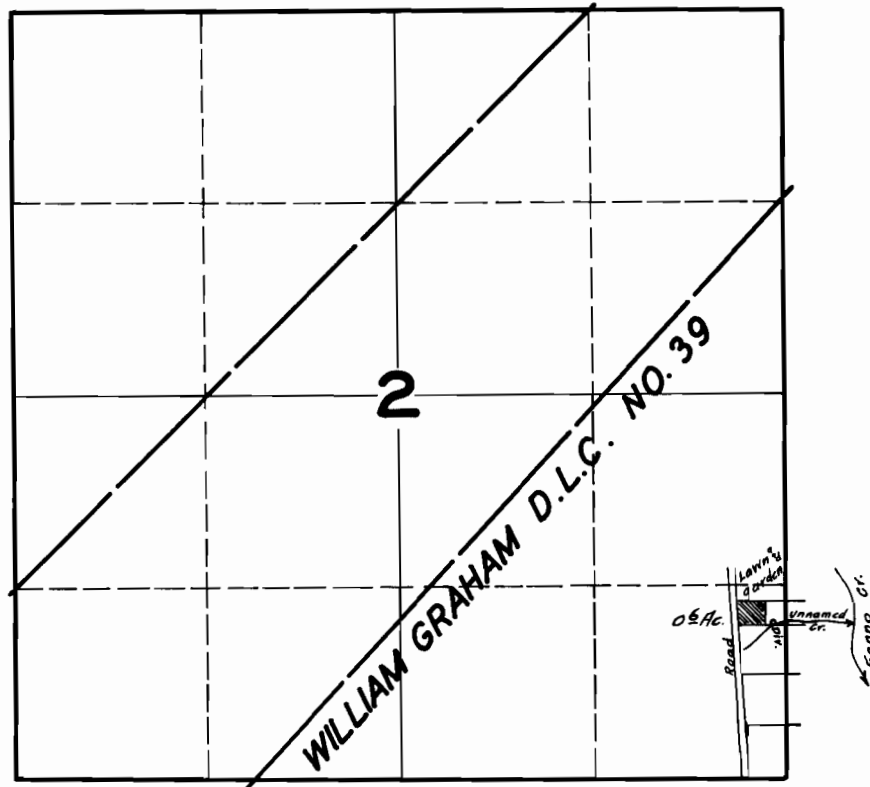

FINAL PROOF SURVEY

UNDER

Application No. 21305 Permit No. 16708

IN NAME OF

CARL VREELAND

Surveyed AUG. 21 1946, by