


T.13S.R.1E.W.M.

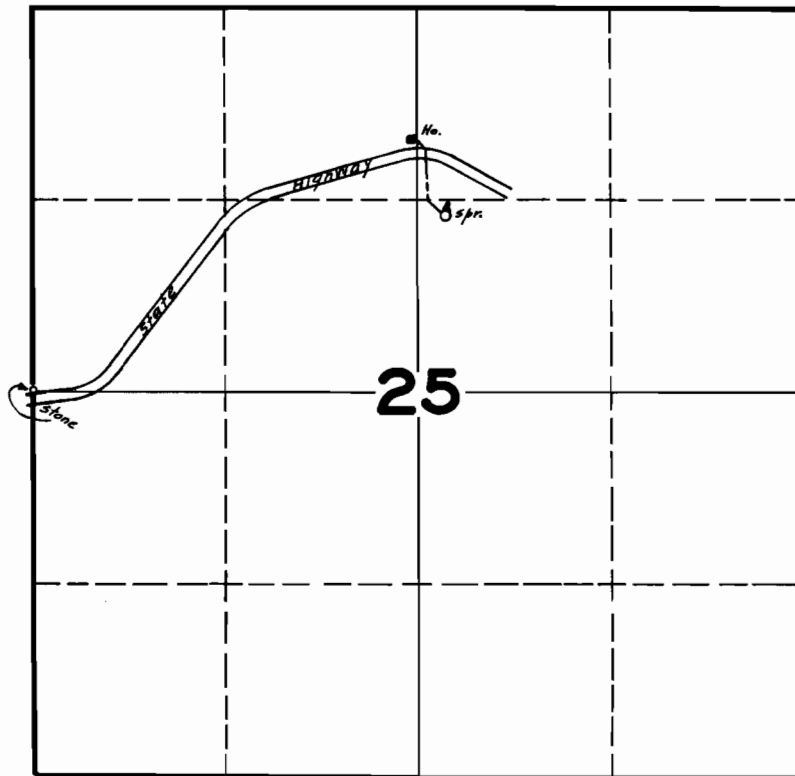

FINAL PROOF SURVEY UNDER

Application No. 21379 Permit No. 16770

IN NAME OF
CHAS. A. PECK

Surveyed JULY 26 1946, by [Signature]