


T.5S.R.4W.W.M.

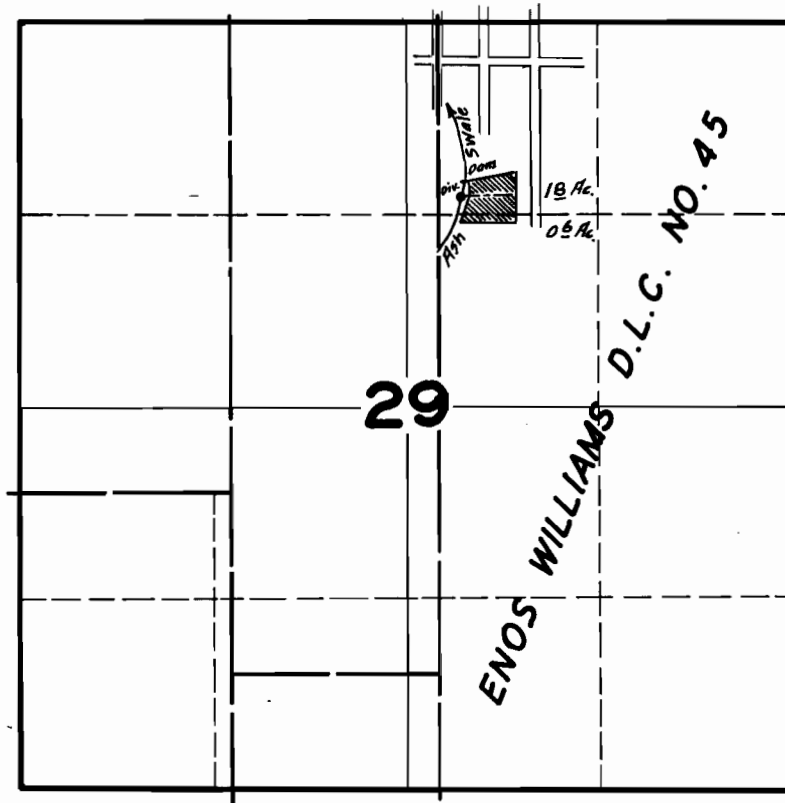

FINAL PROOF SURVEY
UNDER

Application No. 21410 Permit No. 16801

IN NAME OF

A. A. ANDERSON

Surveyed AUG. 3, 1946, by