


T. 7S. R. 3W. W.M.

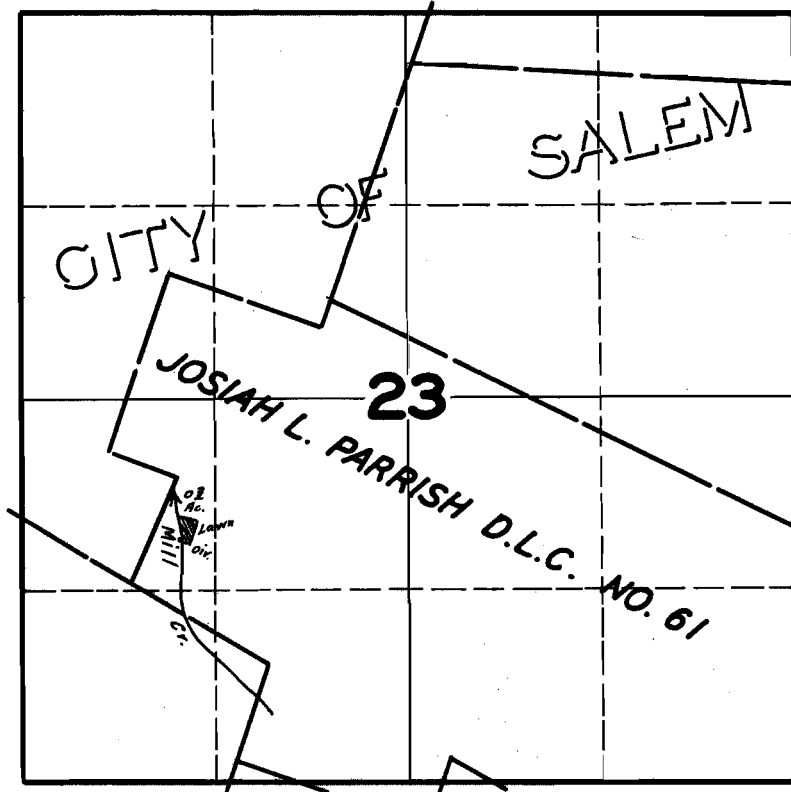

**FINAL PROOF SURVEY**

UNDER

Application No. 21477 Permit No. 16846

IN NAME OF

GRACE THOMPSON

Surveyed AUG. 14 1946, by

Handwritten signature of the surveyor.