


T. 2 S. R. 4 W. W. M.

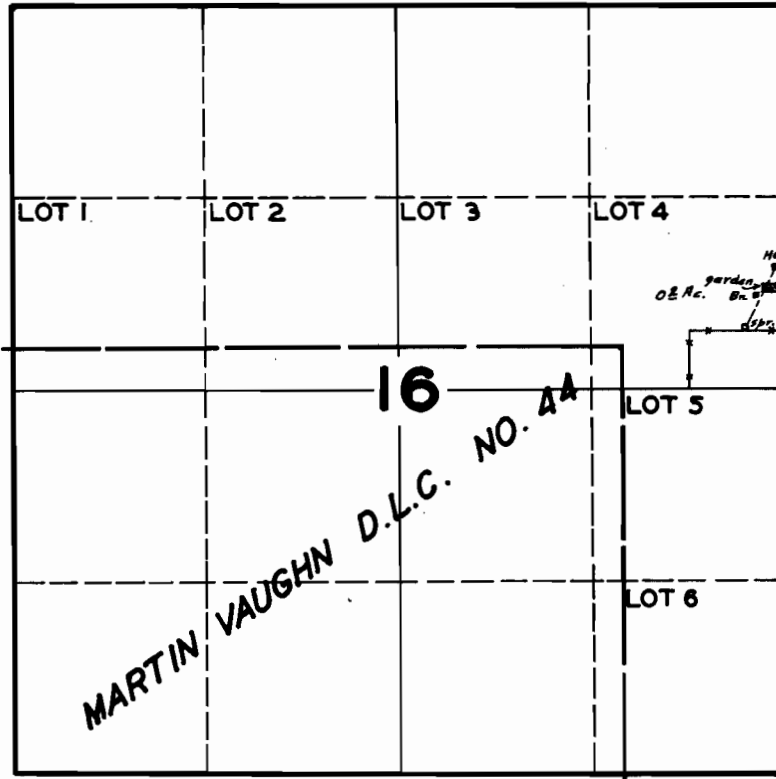

FINAL PROOF SURVEY UNDER

Application No. 21526 Permit No. 16880

IN NAME OF

ORIN M. & CLETA DAVIS

Surveyed SEP. 5 1946, by [Signature]