


T. 10S. R. 7W.W.M.

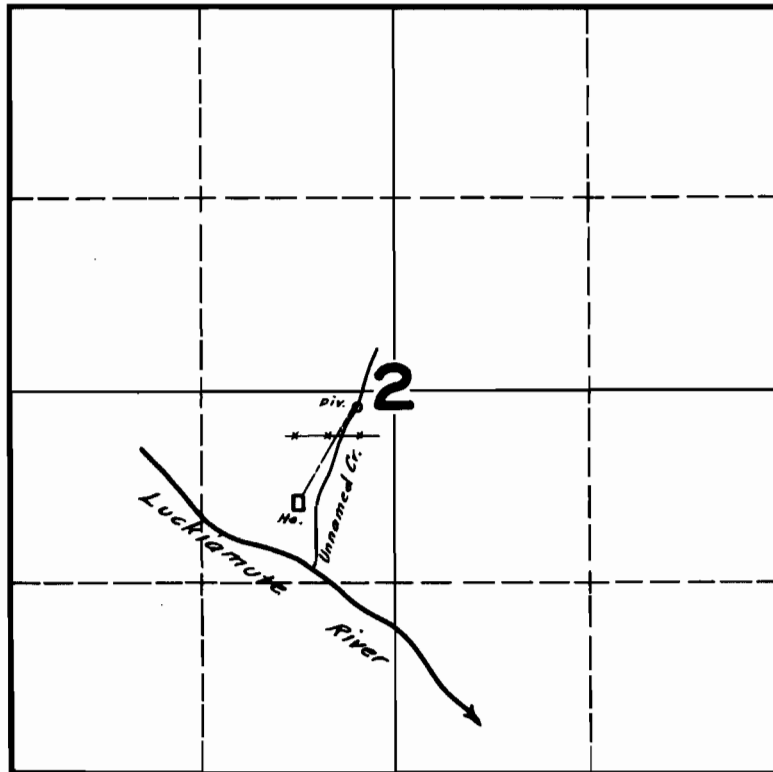

**FINAL PROOF SURVEY
UNDER**

Application No. 21559 Permit No. 16904

IN NAME OF

A. L. KENWORTH

Surveyed JULY 20 1946, by

A large, stylized handwritten signature in black ink, appearing to read 'J. H. Russell', is written over the printed name 'A. L. KENWORTH' and extends over the 'Surveyed' text.