


T.16S.R.7W.W.M.

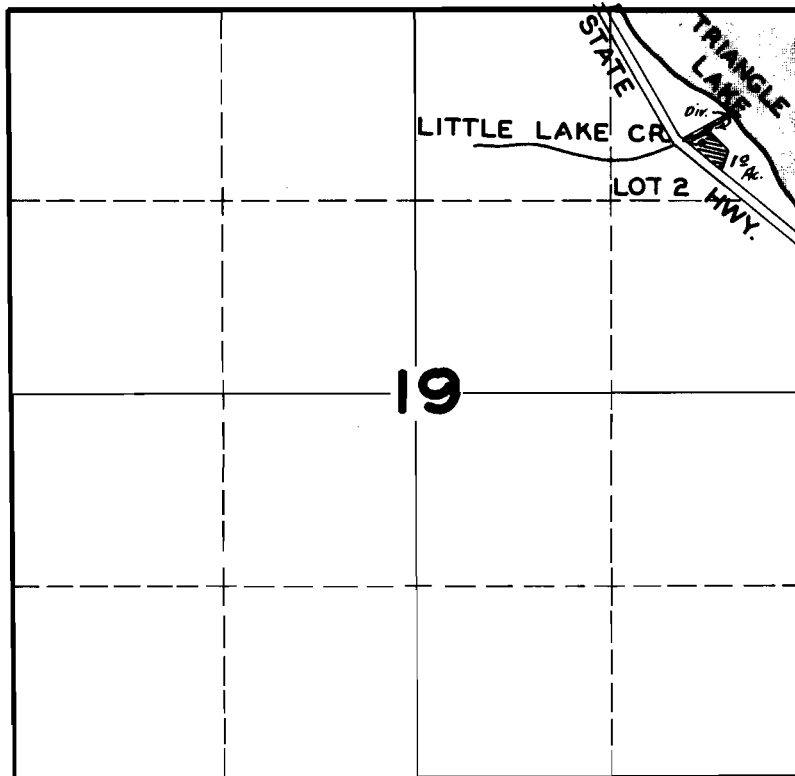

FINAL PROOF SURVEY

UNDER

23308

18382

Application No. 21044 Permit No. 16489

IN NAME OF

MRS. ETHEL HABERLAND

Surveyed AUG. 11, 1947, by JAS. E. BUNNELL

Application No. 23308
Permit No. 16489