


Sec. 30, T. 39 S., R. 2 E. W.M

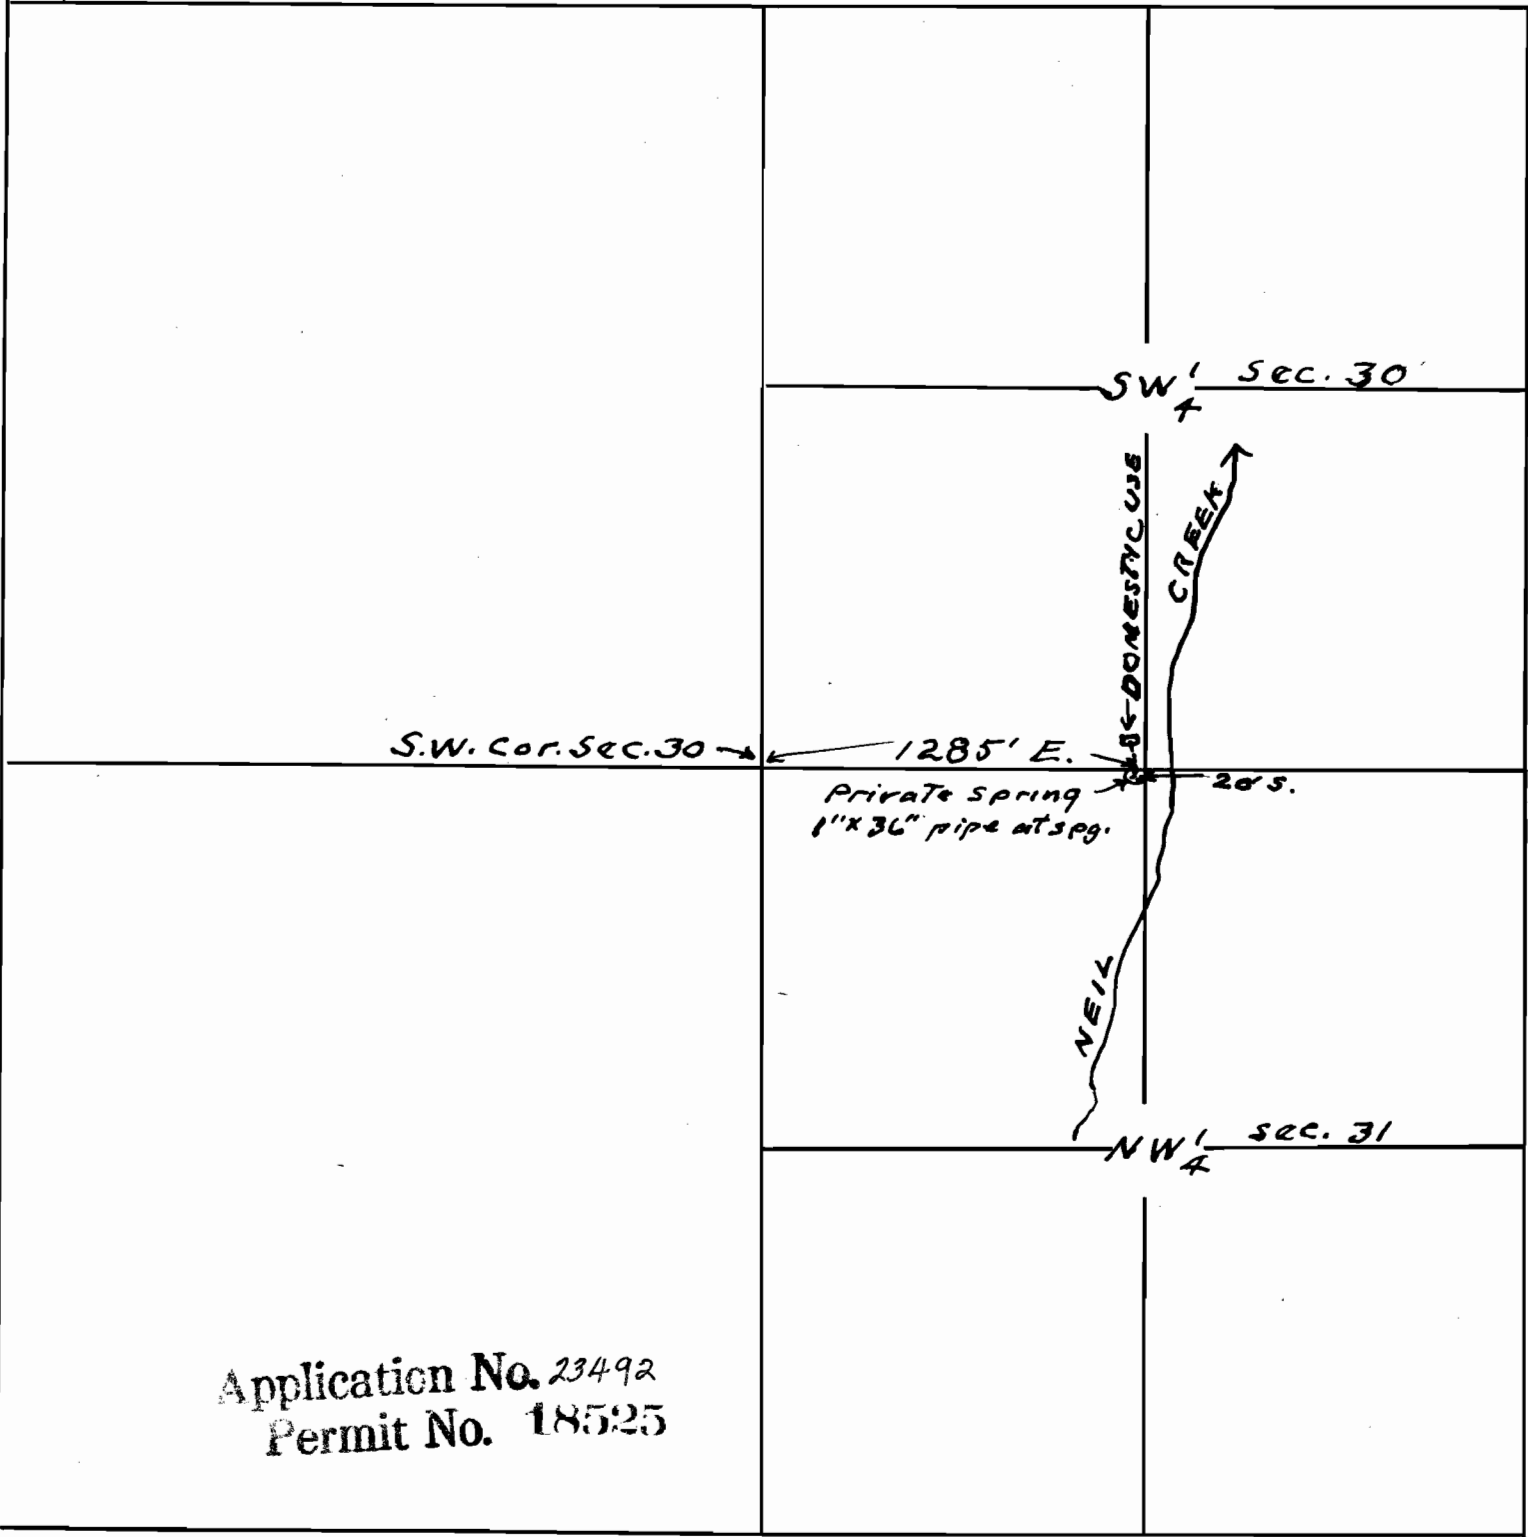

Map to accompany application of William Young for use of water from private spring for domestic purposes.

This office 10/5/45 *W. Young*

23492

15-24