


Sec. 31, T. 37 S., R. 1 W. W.M.

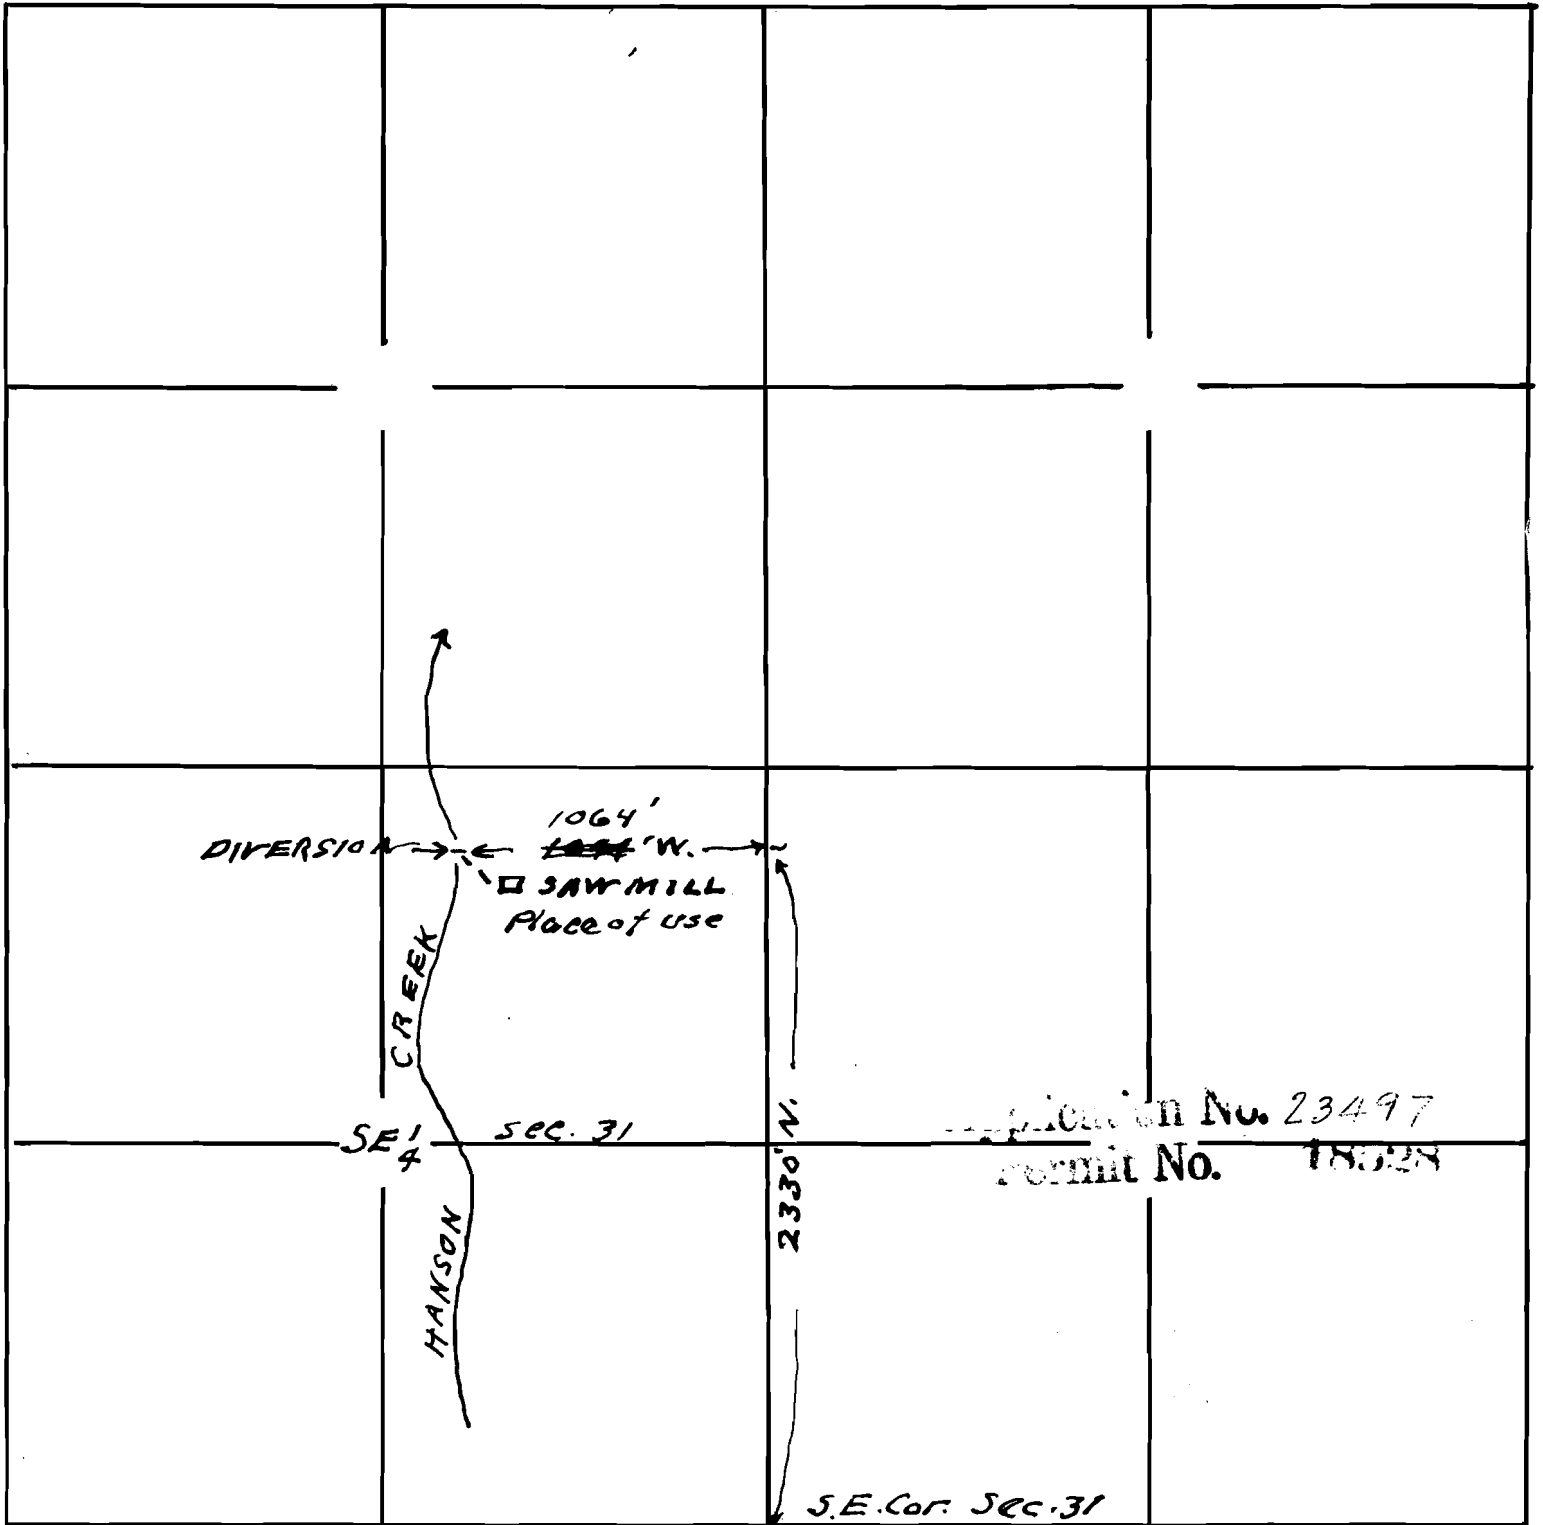

Map to accompany application of Highway Auto Company for use of water from Hanson Creek for fire protection & manufacturing purposes.

This office 10/20/48 *Walter Smith*

23497