


T. 29S. R. 5W. W.M.

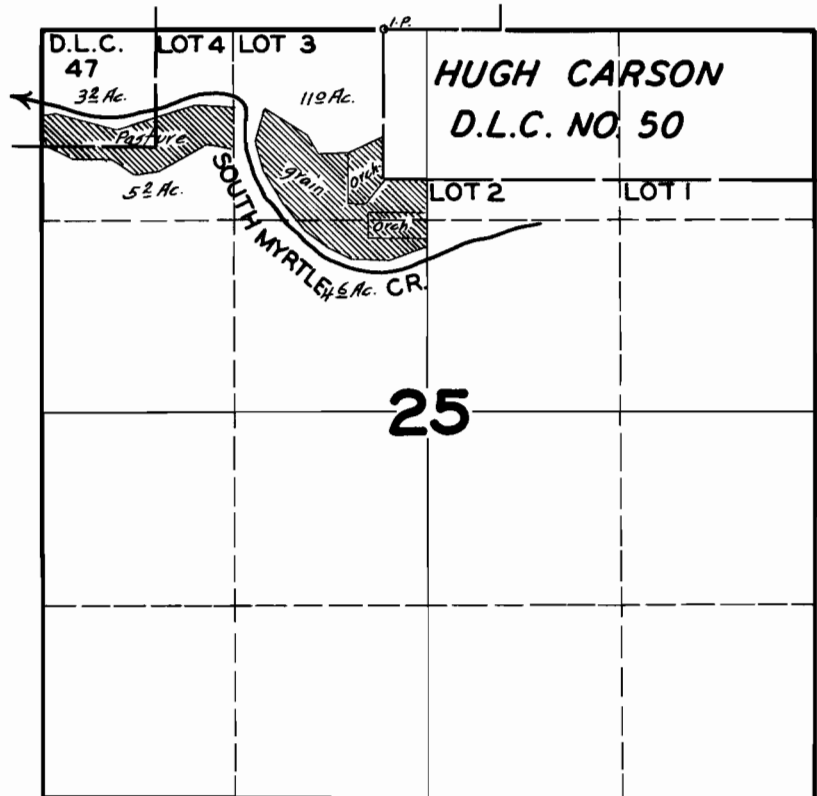

FINAL PROOF SURVEY UNDER

Application No. 17634 Permit No. 13332

IN NAME OF

GEORGE TRASK

Surveyed JUNE 4 1947, by JAS. E. BUNNELL