


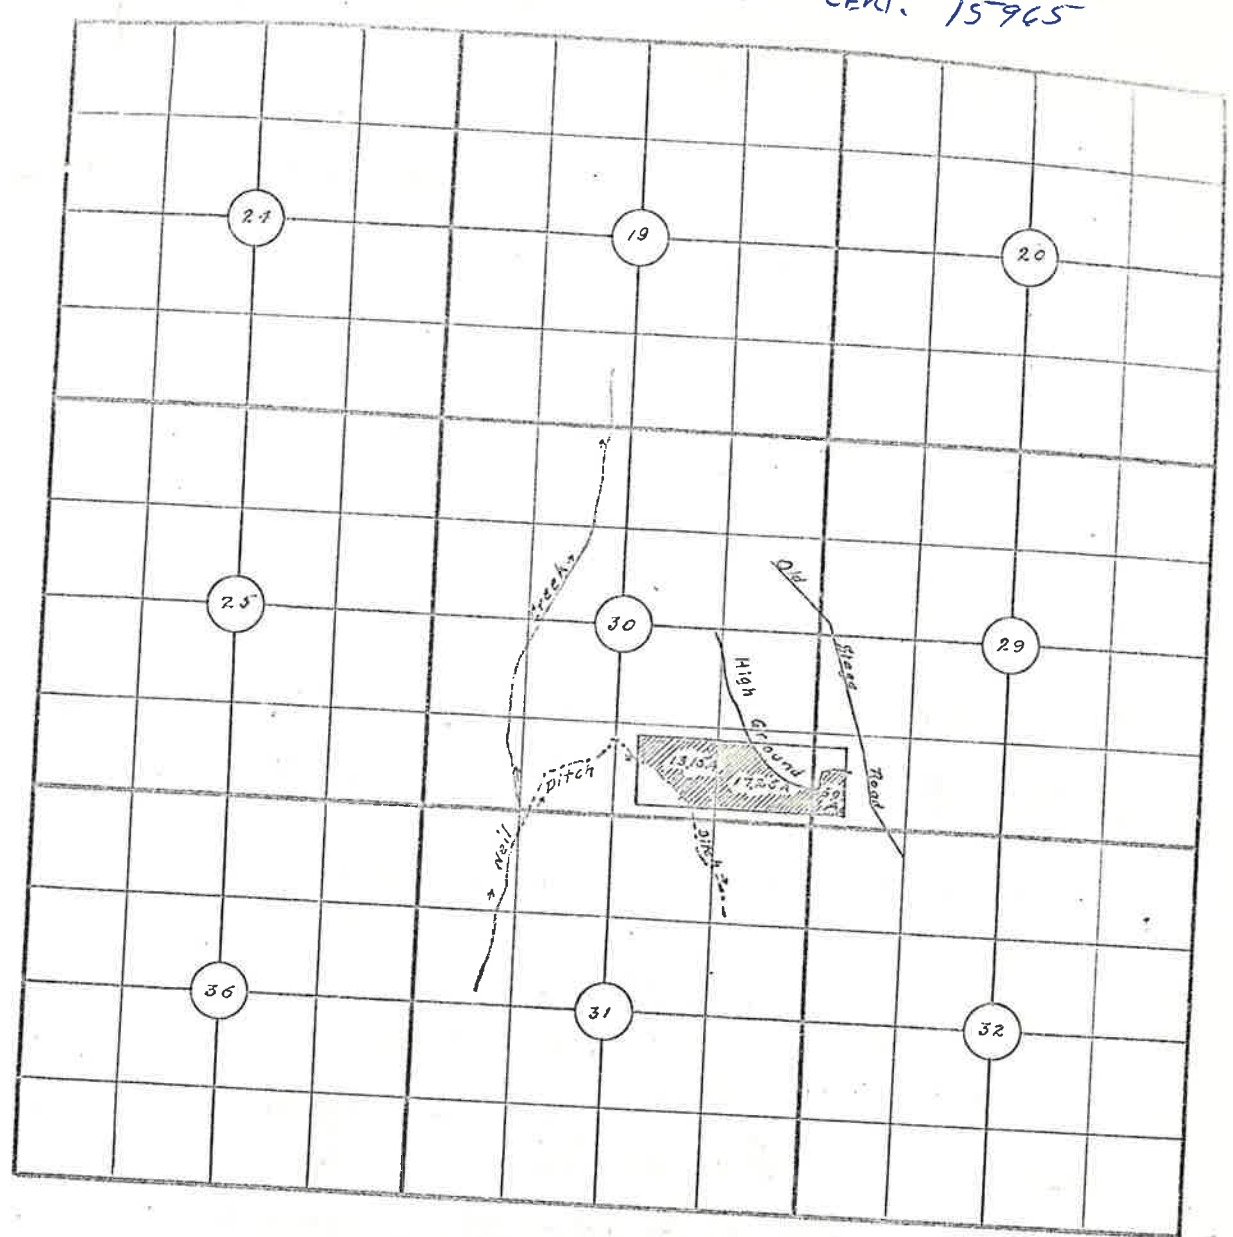

I, Frank A. Grisez, of Ashland, Oregon, do hereby certify that this map was made from notes taken during an actual survey made by me on Sept. 16, 1911, and that it correctly represents the lands described in the accompanying description, together with the location of streams etc. in the immediate vicinity, and has written thereon the areas in each smallest legal subdivision now under irrigation.

Frank A. Grisez 159

7. Q.—How is the water utilized? A.—*By*

8. Q.—State the means of utilizing such water, giving the name by which the ditch is most commonly known, if a ditch is used.

A.—*Smith, Deane and Tolman ditch (now known as French, Deane & Tolman ditch)*

9. Q.—State the interest claimant has in such ditch, with the names of any other water users interested therein.

A.—*The right to perpetual use of so much water from said ditch as will flow through a one inch pipe under a head of 1 foot. This right was granted by J. C. Tolman & Deane Matiffa to the Oregon C. & N. Ry. Co. by deed dated May 27, 1902, page 573, J. C. Tolman & Deane Matiffa.*

10. Q.—State the date of the beginning of construction. A.—*1852.*

11. Q.—State the date of completion? A.—

12. Q.—State the dimensions of the ditch as originally constructed, just below the waste way or head gate?

A.—Width (top) *12 or 13* feet; width (bottom) *6 or 7 1/2* feet; depth *2 or 3* feet; grade, or fall in feet per 1000 feet, *36 9/10* feet.