





# Township 15

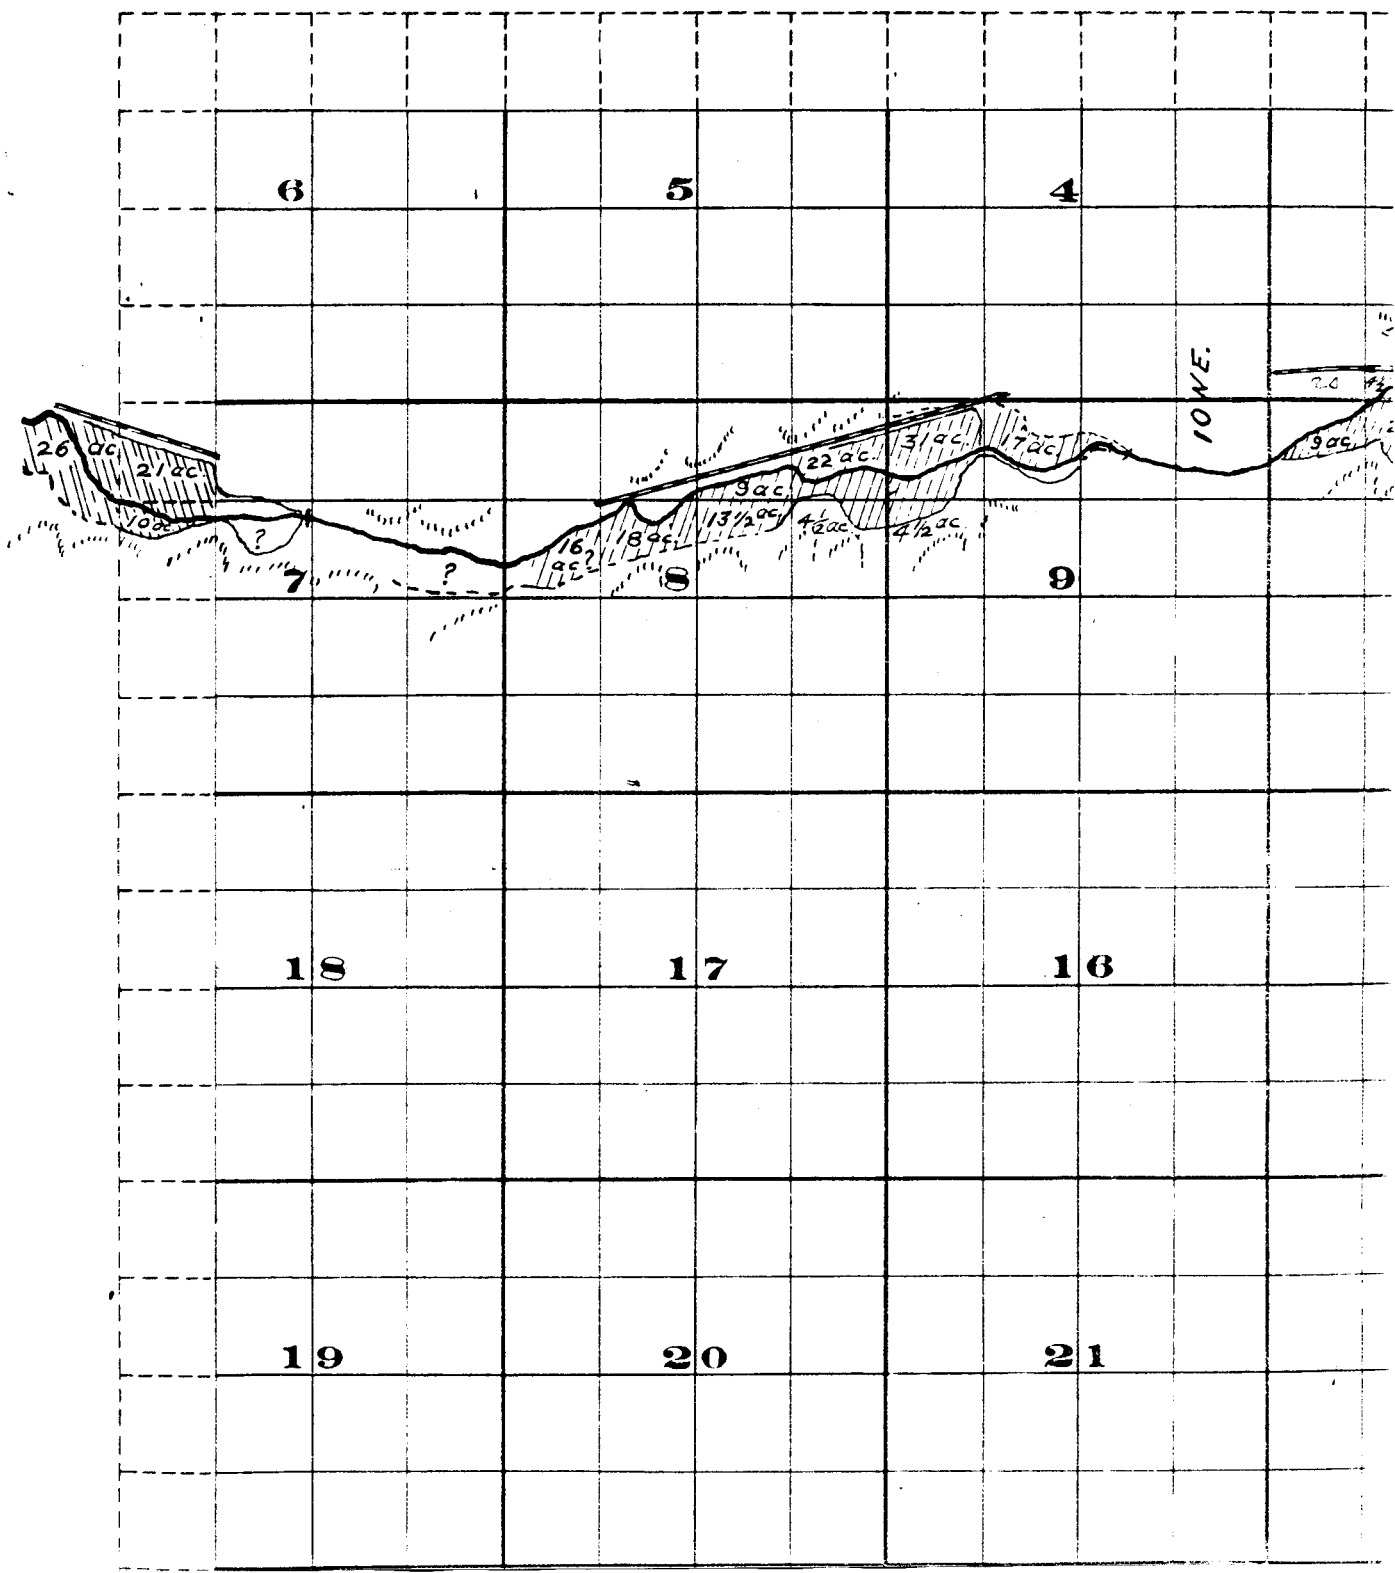

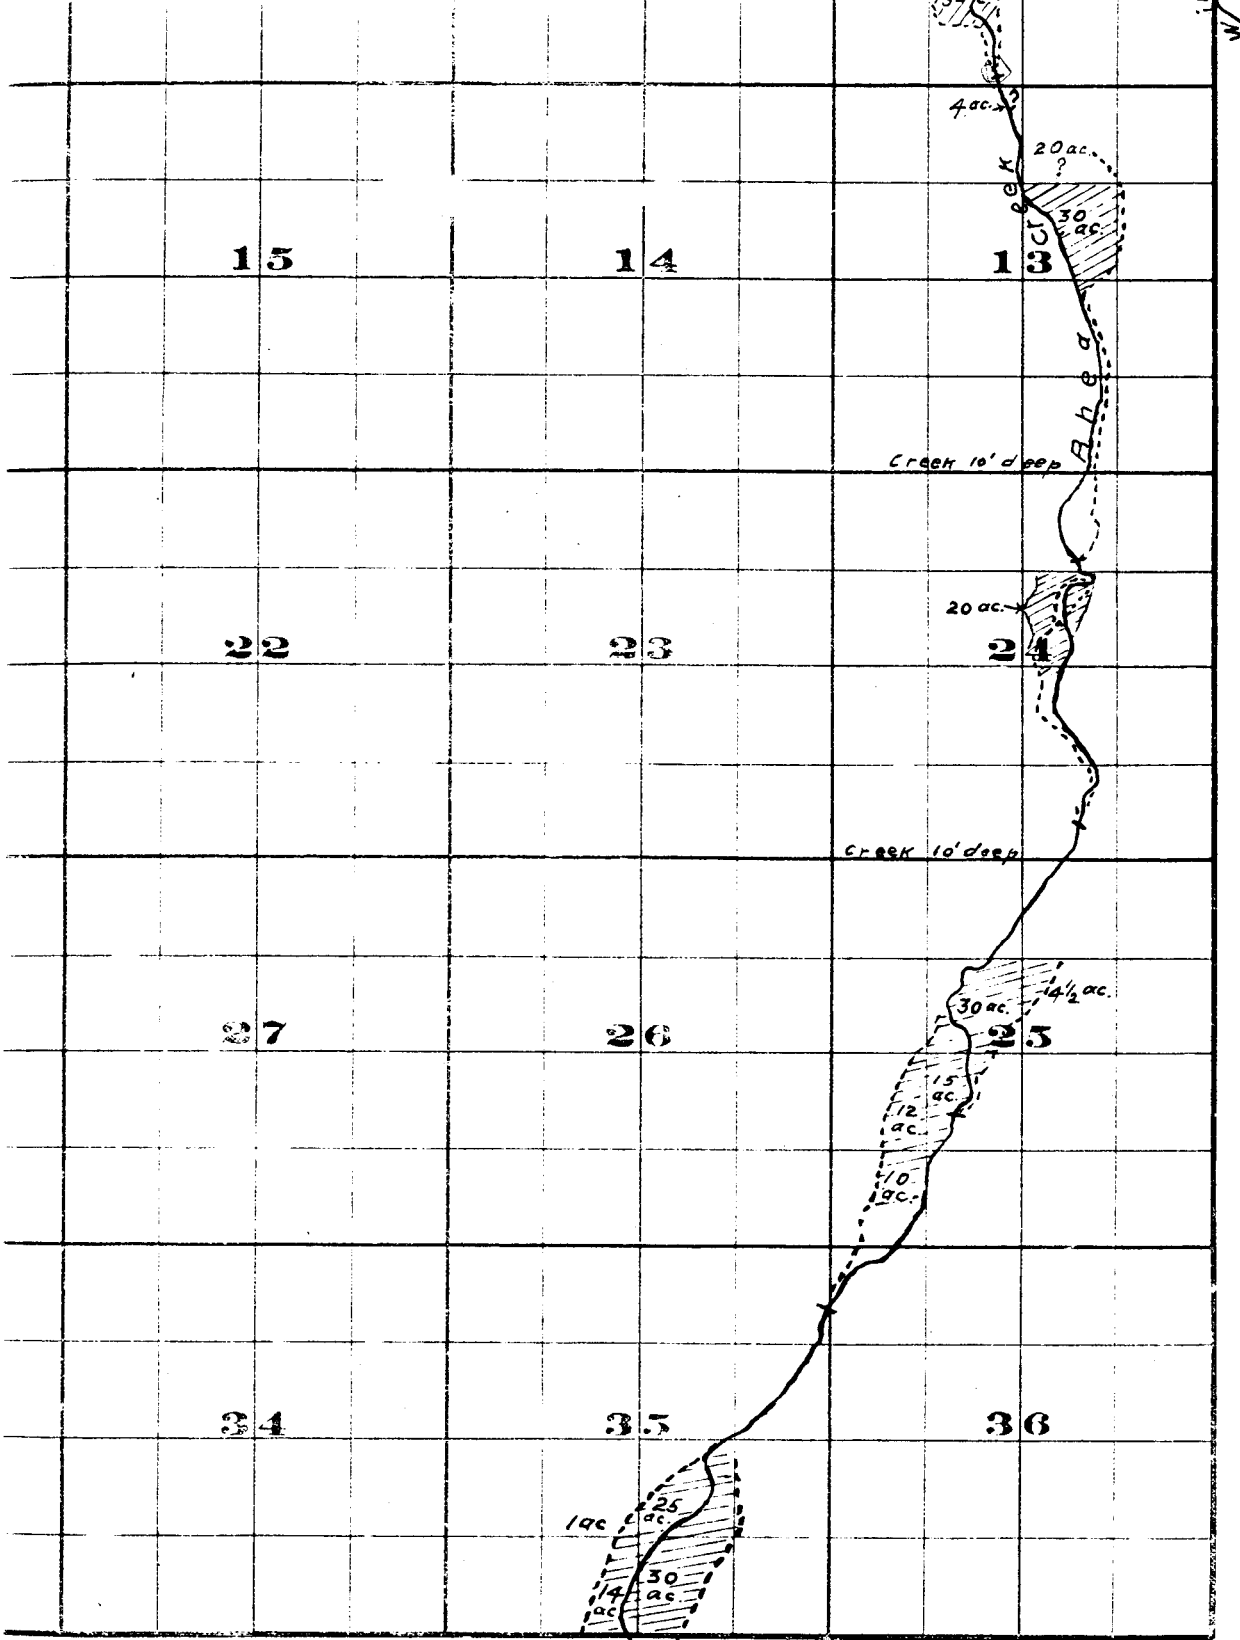



FROM OFFICE OF THE STATE ENGINEER, SALEM, OREGON

*Willow Creek Adjudication.*

1 S. 24 E  
R. 1 E. T. 5 E