



Ship 2 N. , Range 23 E.W.M.

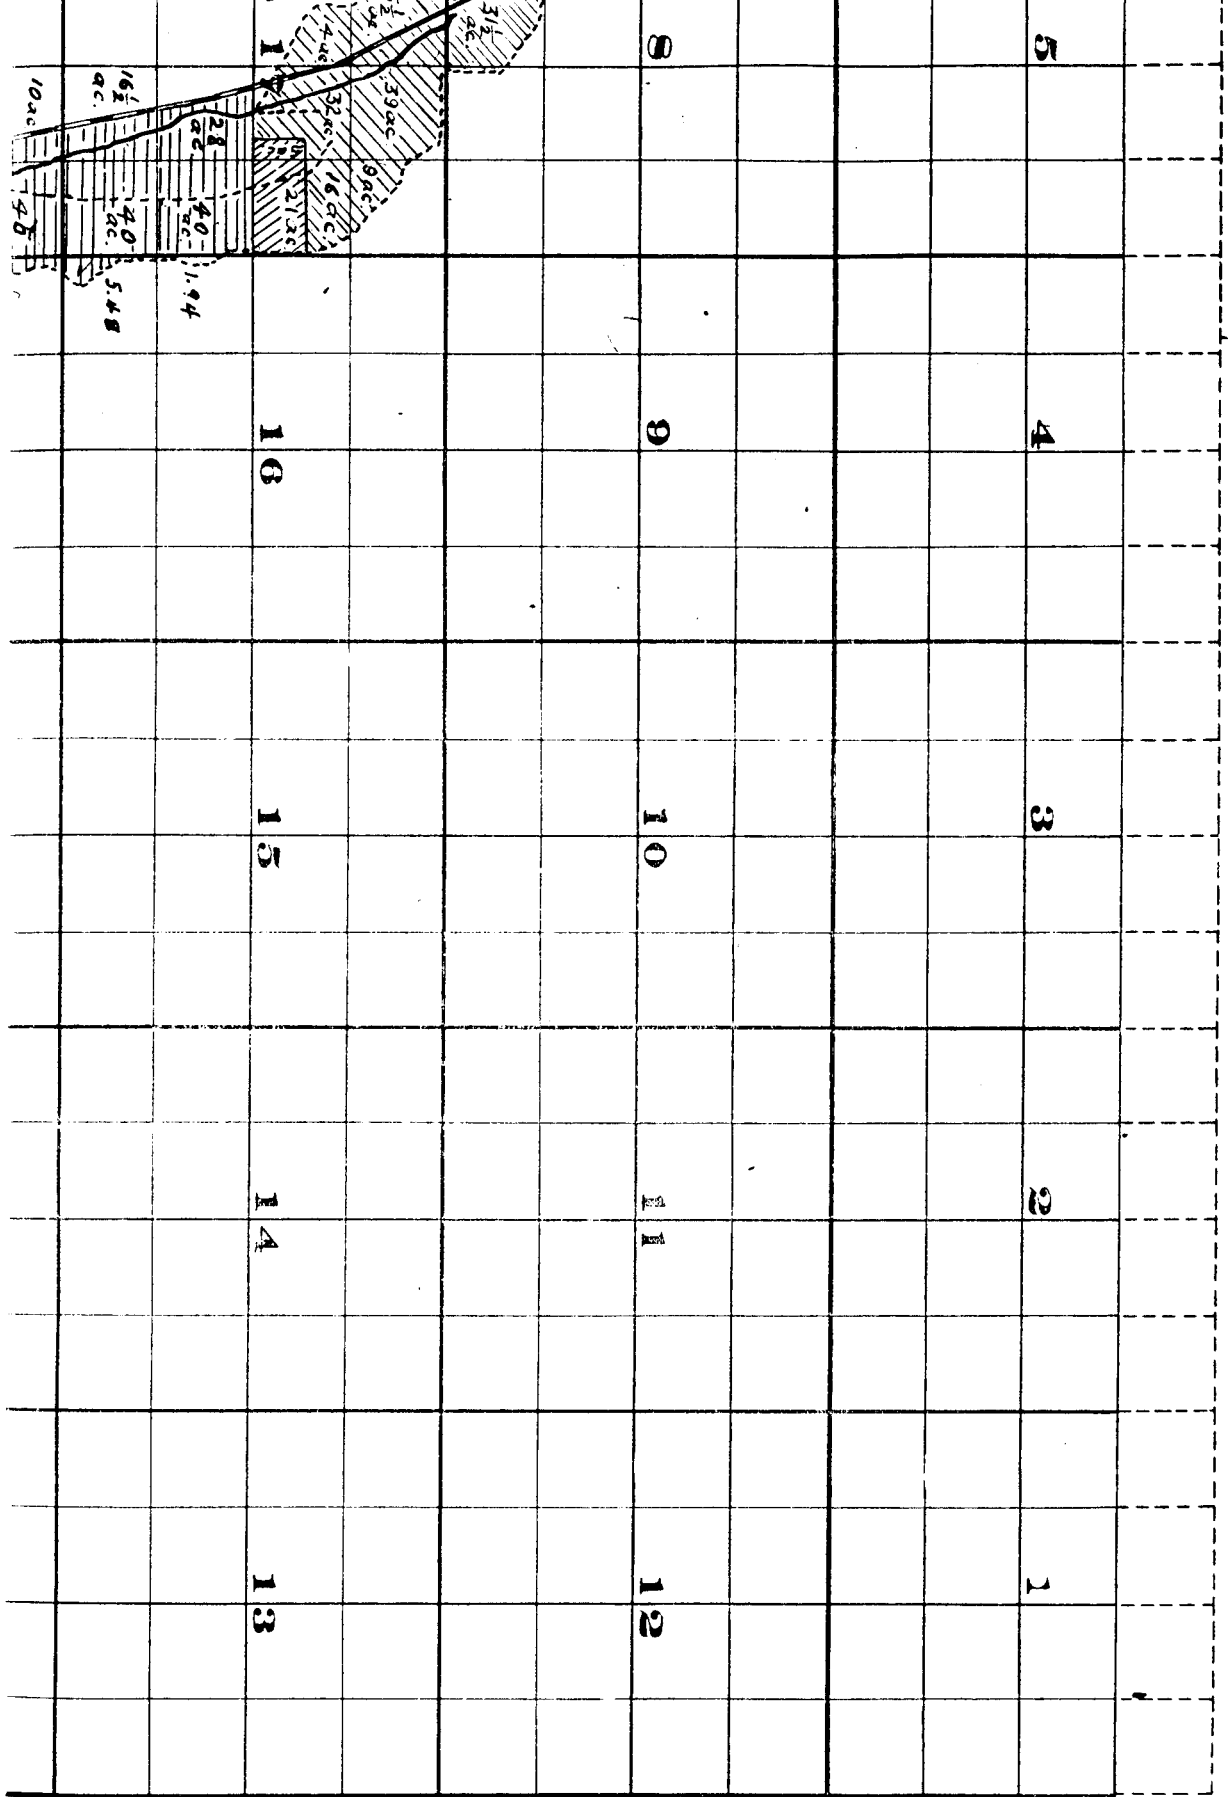

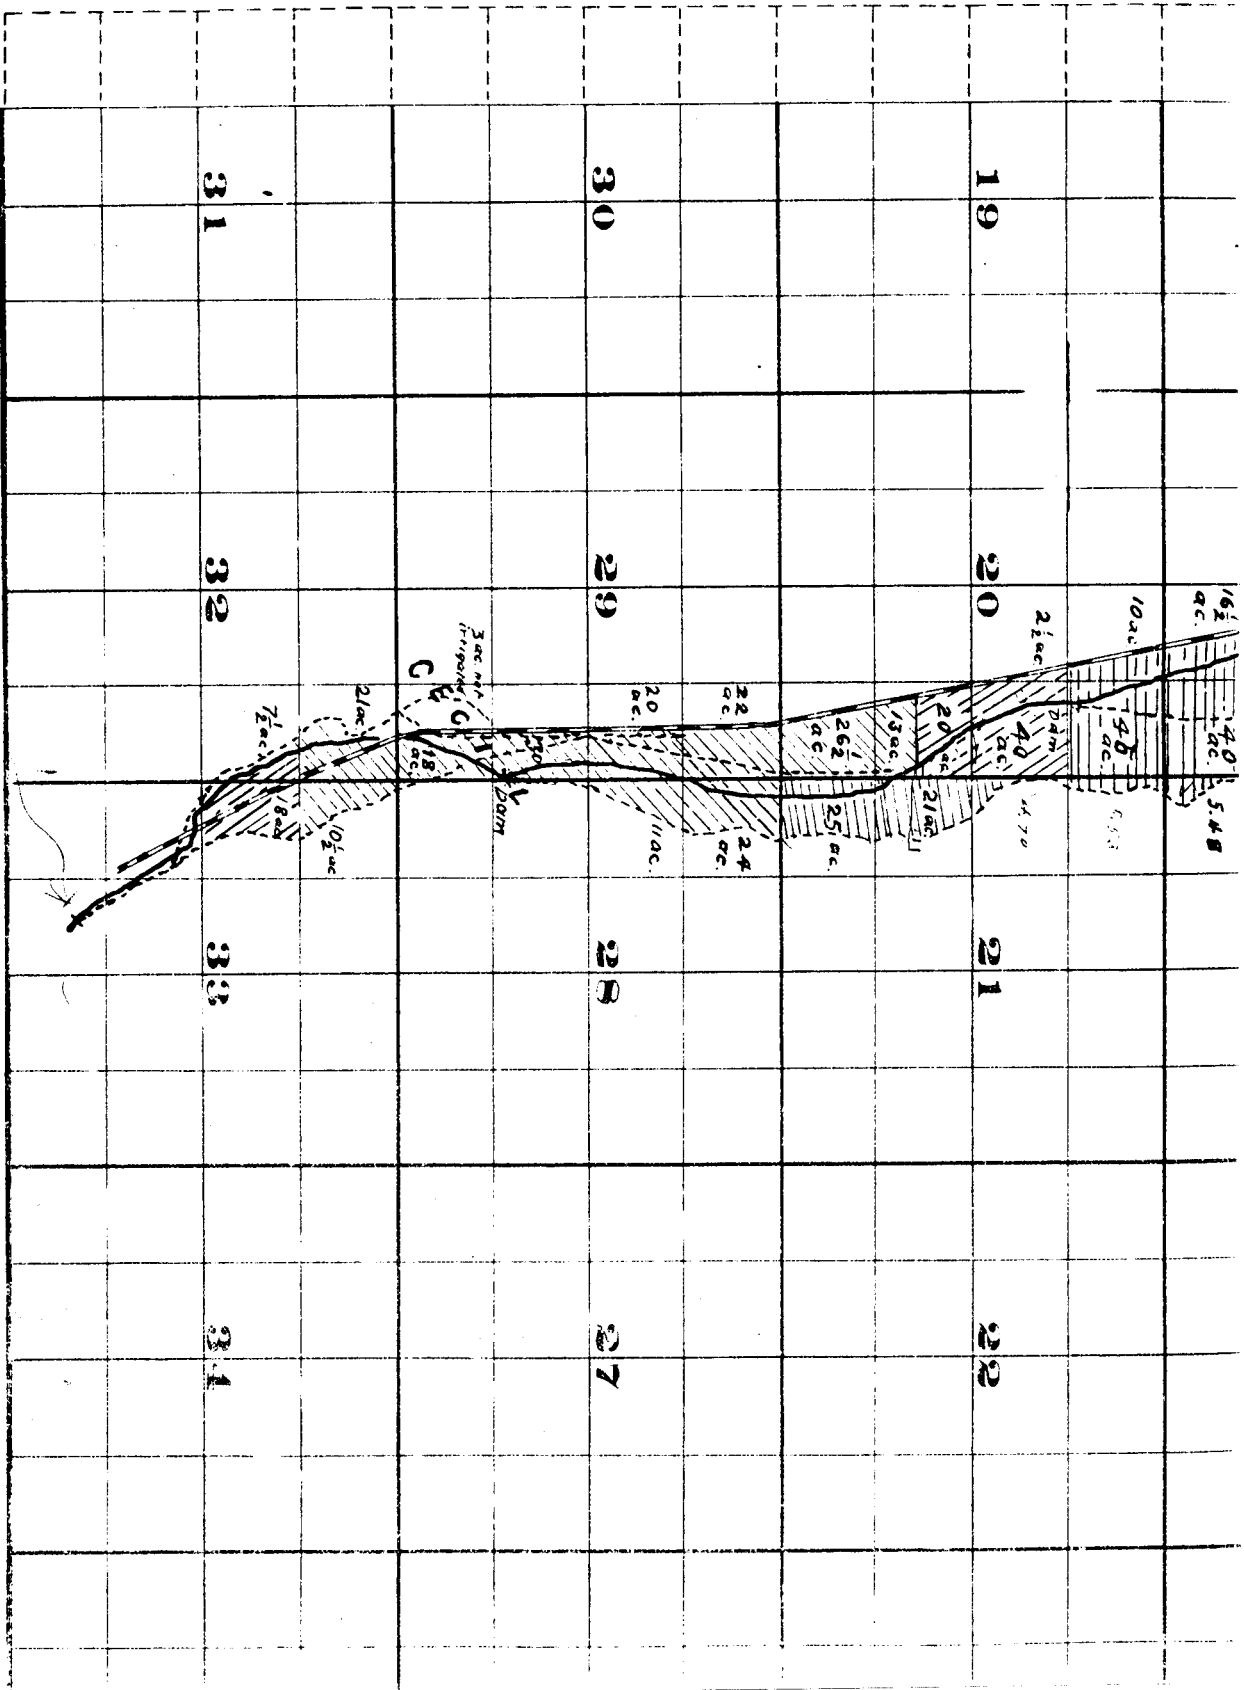




Surveyed by H.K. Donnelly July 1909.

John H. Lewis - State Engineer.

Examined July 14, 1909.

Willie

