


15				14				13	
22				23				24	
27				26				25	
34				35				36	

FROM OFFICE OF THE STATE ENGINEER, SALEM, OREGON

Willow Creek Adjudication.

35.28 E.

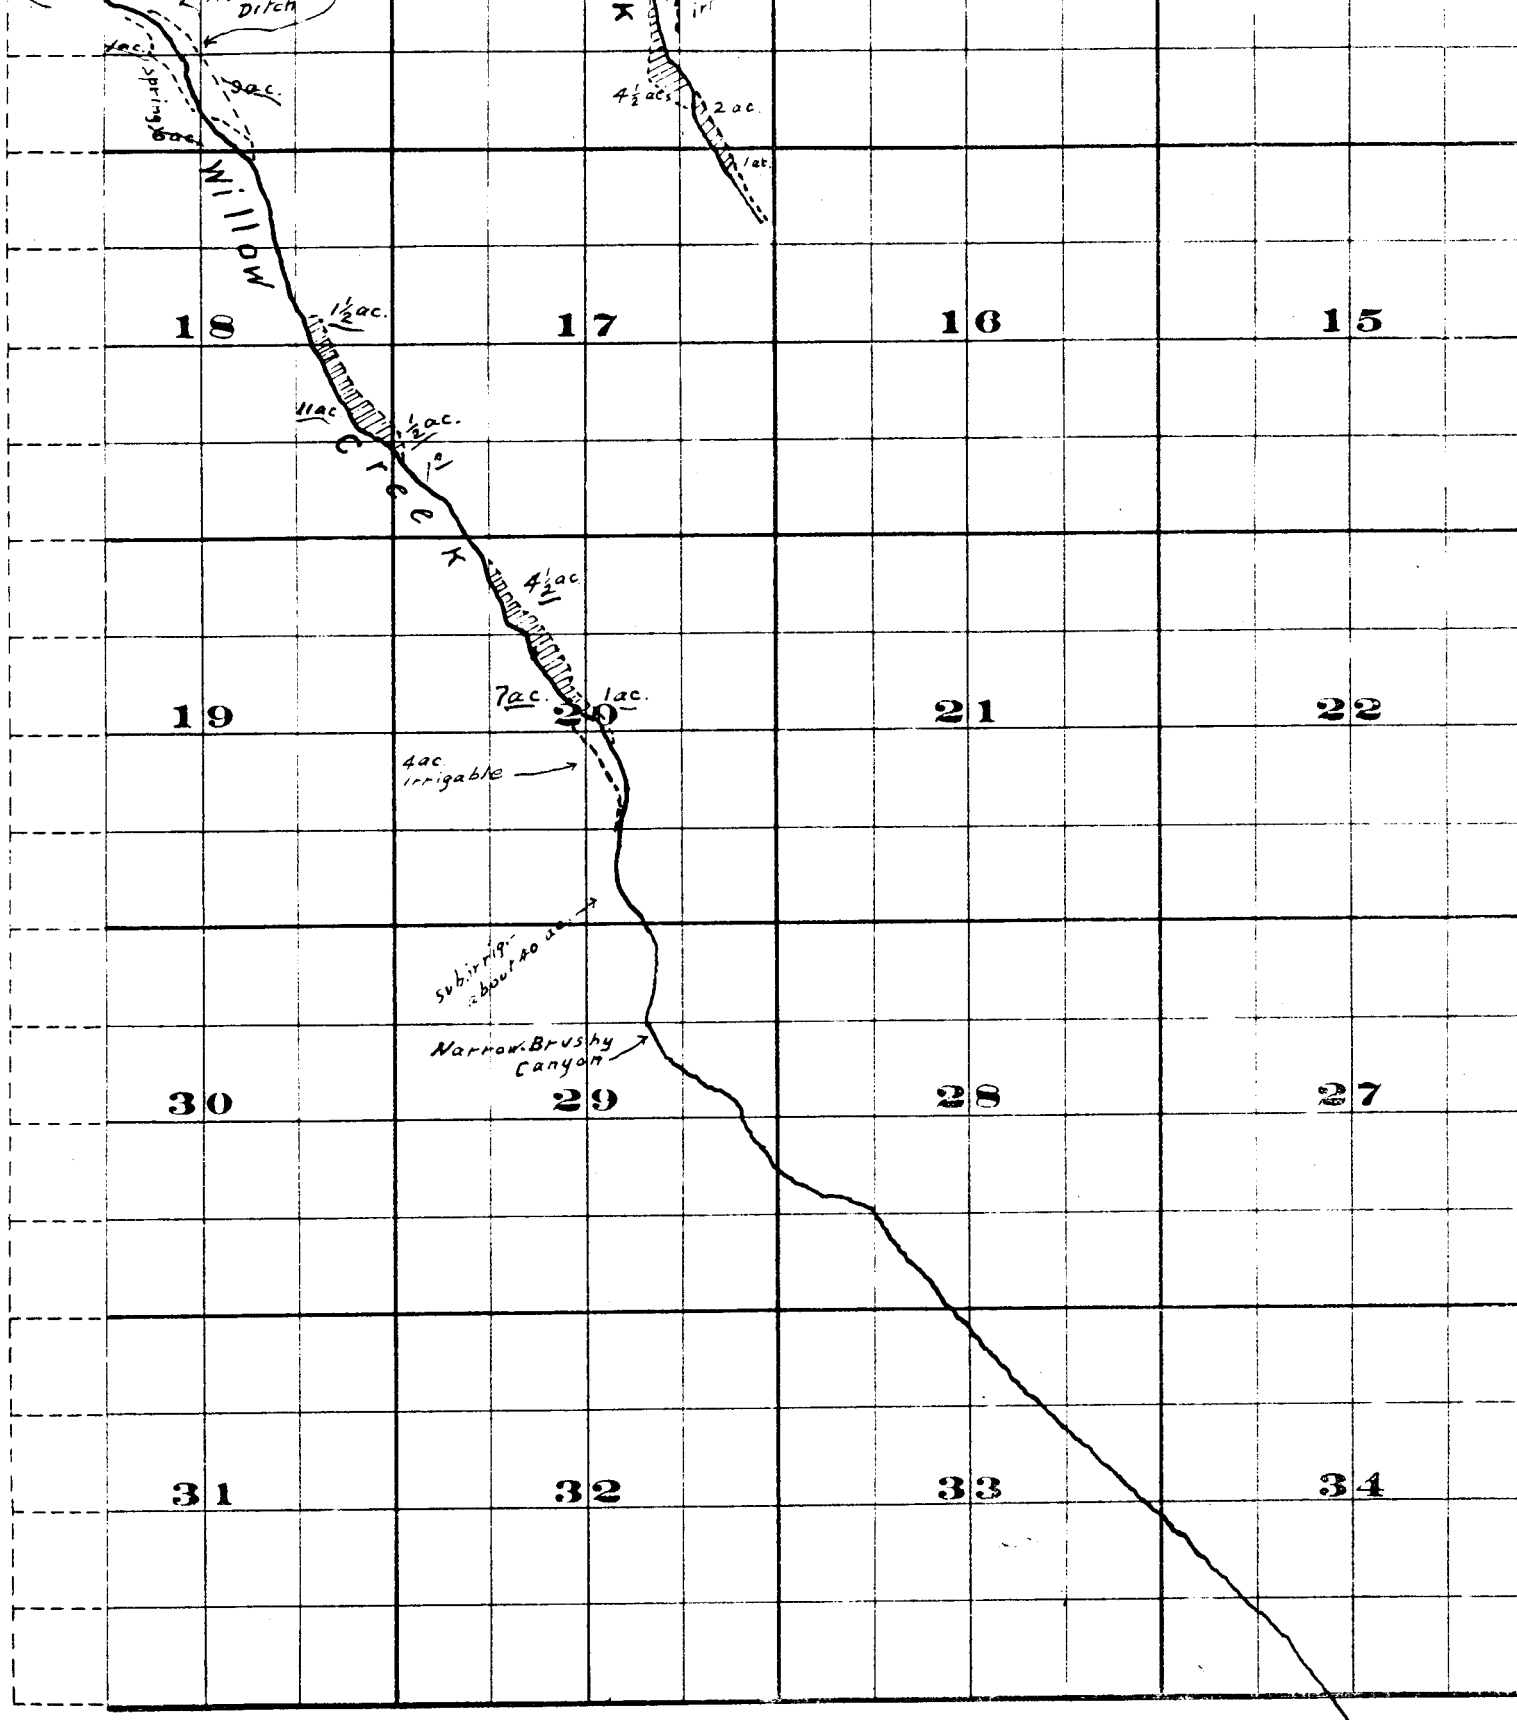


THE S. A. BRISTOL CO. PRINTERS & BOUNDINGERS, CHICAGO, ILL.

Hinton Creek Surveyed by H.K. Donnelly July 1909
 Willow Creek Surveyed by R.D. Cooper July 1909

John H. Lewis - State Eng'r.

Examined July 14, 1909.

,

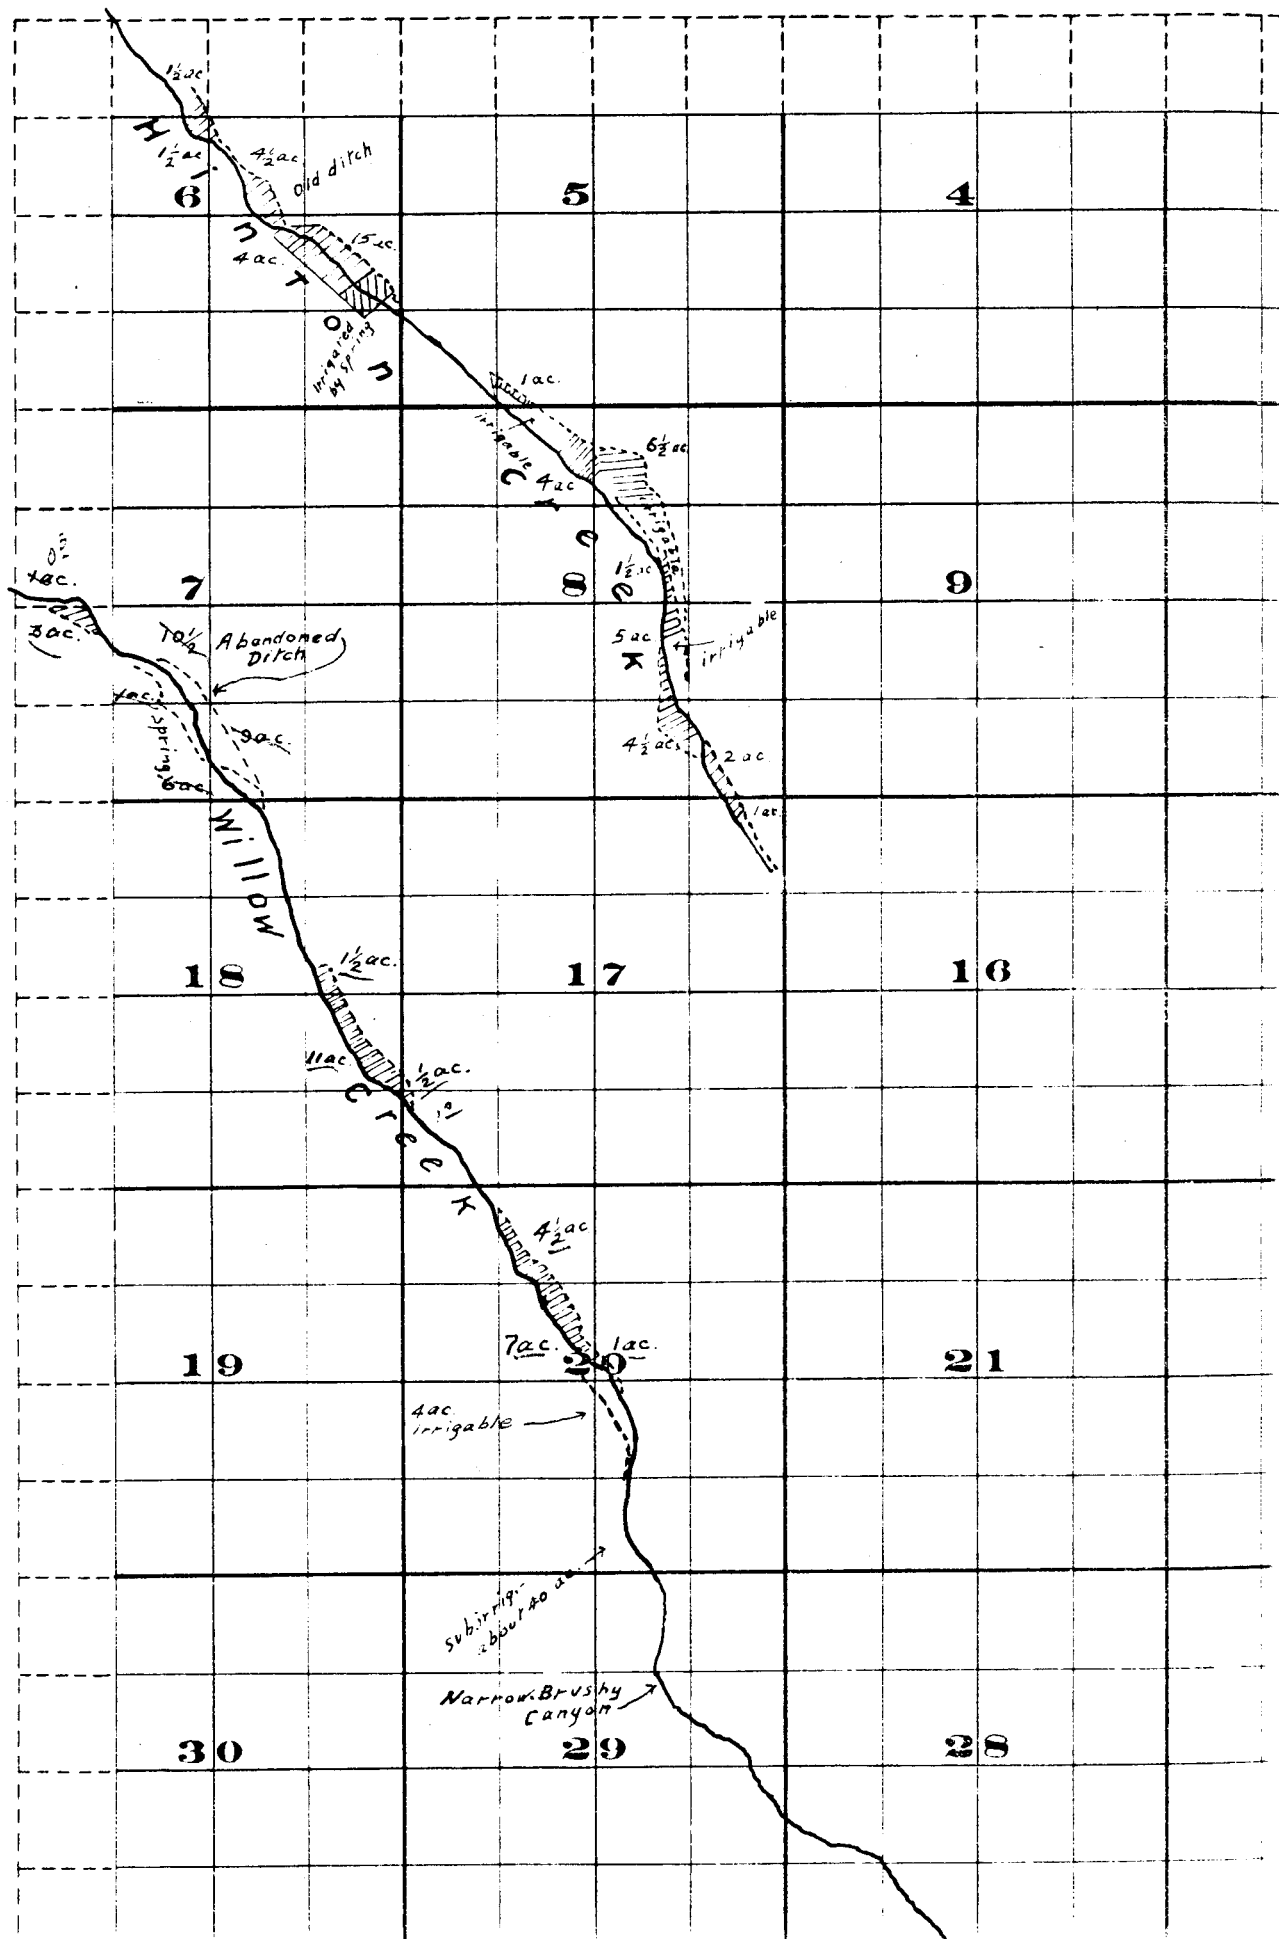

4		3		2		1
9		10		11		12
16		15		14		13
21		22		23		24