


T.7S.R.6W.W.M.

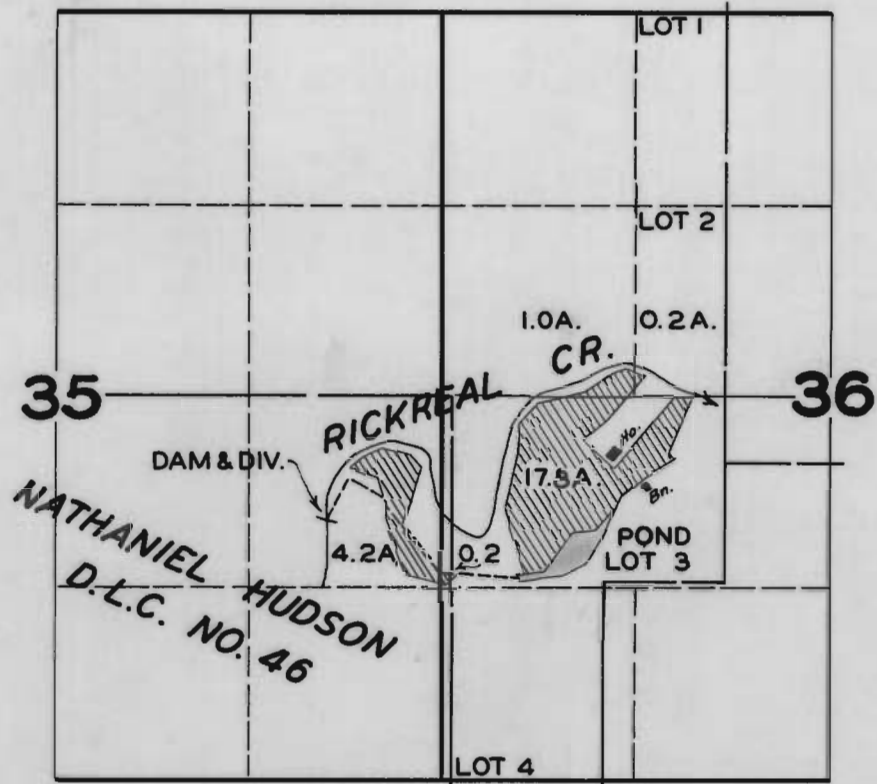

FINAL PROOF SURVEY
UNDER

Application No. 11459 Permit No. 7919
IN NAME OF

WILLIAM MAURICE DALTON

Surveyed SEP. 20 1948, by JAS. E. BUNNELL