


T.5S.R.2E.W.M.

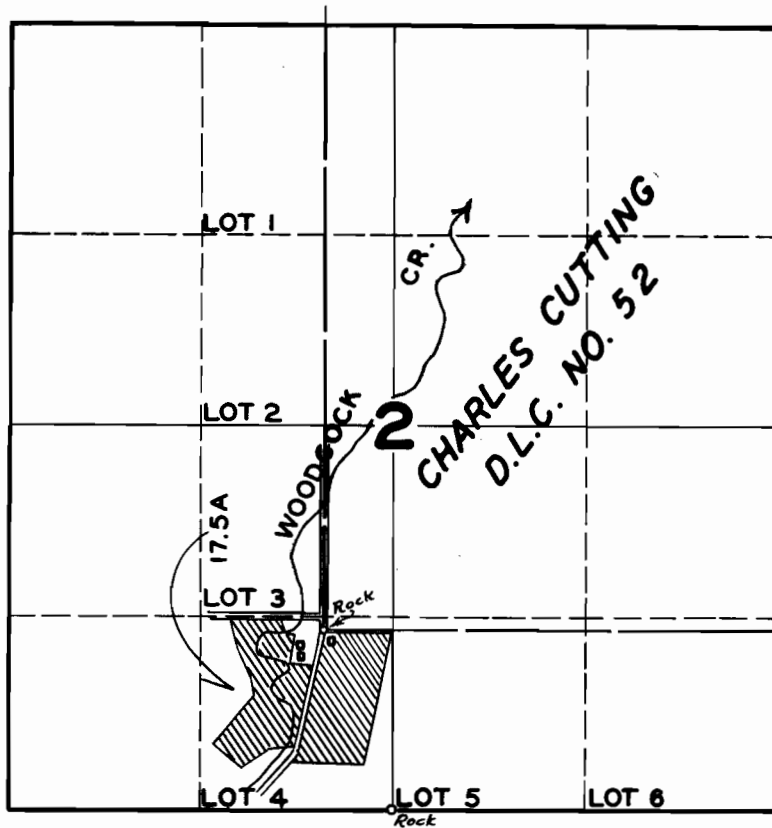

FINAL PROOF SURVEY UNDER

Application No. 13964 Permit No. 10062
IN NAME OF

ALBERT M. THRONSON

Surveyed JULY 2, 1948, by JAS. E. BUNNELL