


T.16S.R.24E.W.M.

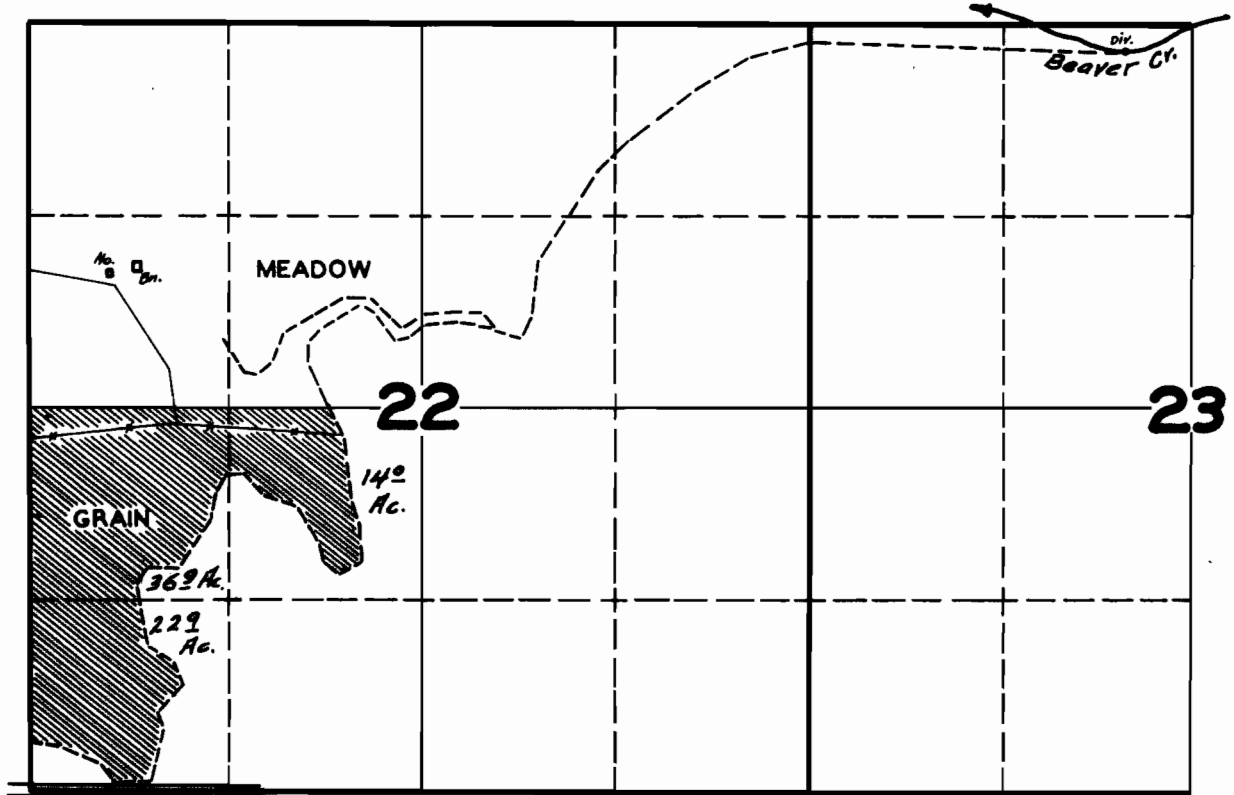

FINAL PROOF SURVEY UNDER

Application No. 15935 Permit No. 11758

IN NAME OF

ROBERT T. LISTER

Surveyed MAY 1 1946, by [Signature]