


T.10S. R.4 & 5 W.W.M.

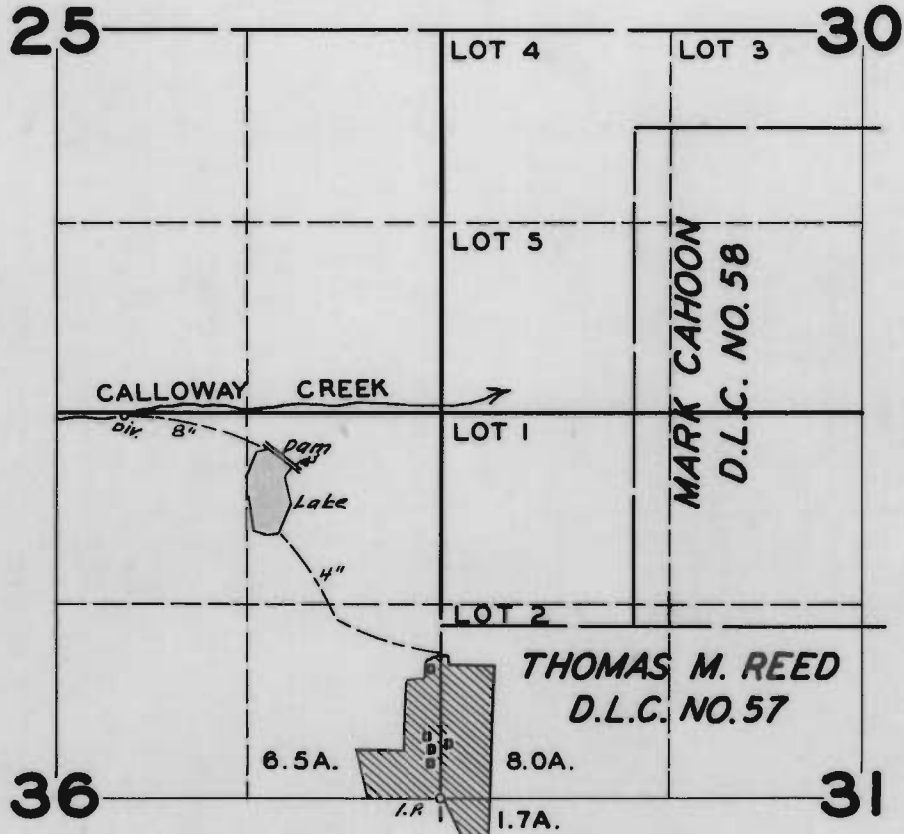

FINAL PROOF SURVEY

UNDER

16744

12526

Application No. **R-16745** Permit No. **R-704**

IN NAME OF

STATE OF OREGON - BOARD OF FORESTRY

Surveyed **JULY 15 1948**, by **JAS. E. BUNNELL**