

HENRY C. HILL D.L.C. NO. 55



33

32

31

36

T. 3S. R. 3W.

T. 4S. R. 3W.

LOT 5


RESERVOIR

5

4

6

12

 

7

LOCATIONS AS SHOWN ON APPLICANTS MAP HAVE BEEN ACCEPTED

FINAL PROOF SURVEY

UNDER

Application No. 16746 Permet No. 12598

IN NAME OF

CITY OF LAFAYETTE

Surveyed MAR. 31 1947, by JAS. E. BUNNELL

T. 3 & 4 S. R. 3 & 4 W. W. M.