


T.3S.R.3W.W.M.

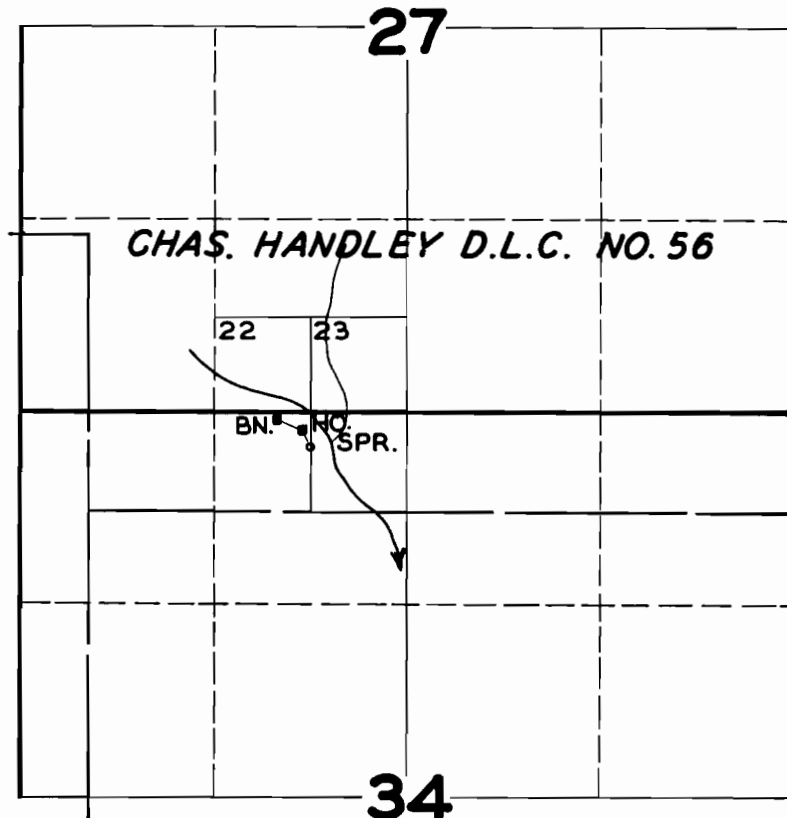

FINAL PROOF SURVEY

UNDER

Application No. **16849** ... Permit No. **12610** ...

IN NAME OF

AXEL L. WESTBERG

Surveyed **MAY 14**, 1948, by **JAS. E. BUNNELL**