


# T.3S.R.1E.W.M.

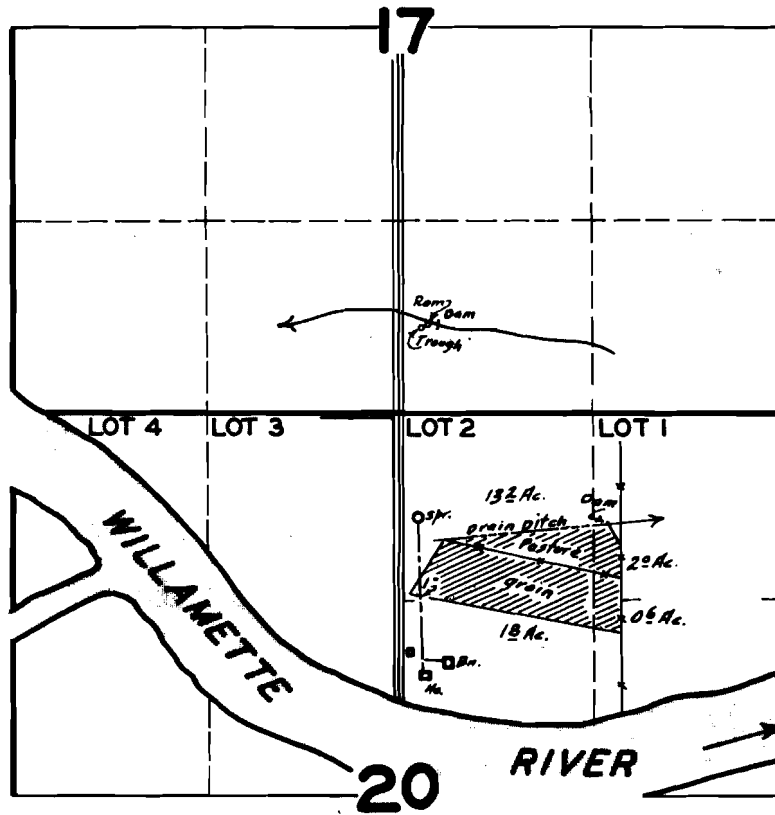

## FINAL PROOF SURVEY UNDER

Application No. 17320 Permit No. 13035

IN NAME OF

F. W. KING

SEP. 1 1944

Surveyed JUN. 9. 1947, by JAS. E. BUNNELL