


# T. 7S. R. 1W. W. M.

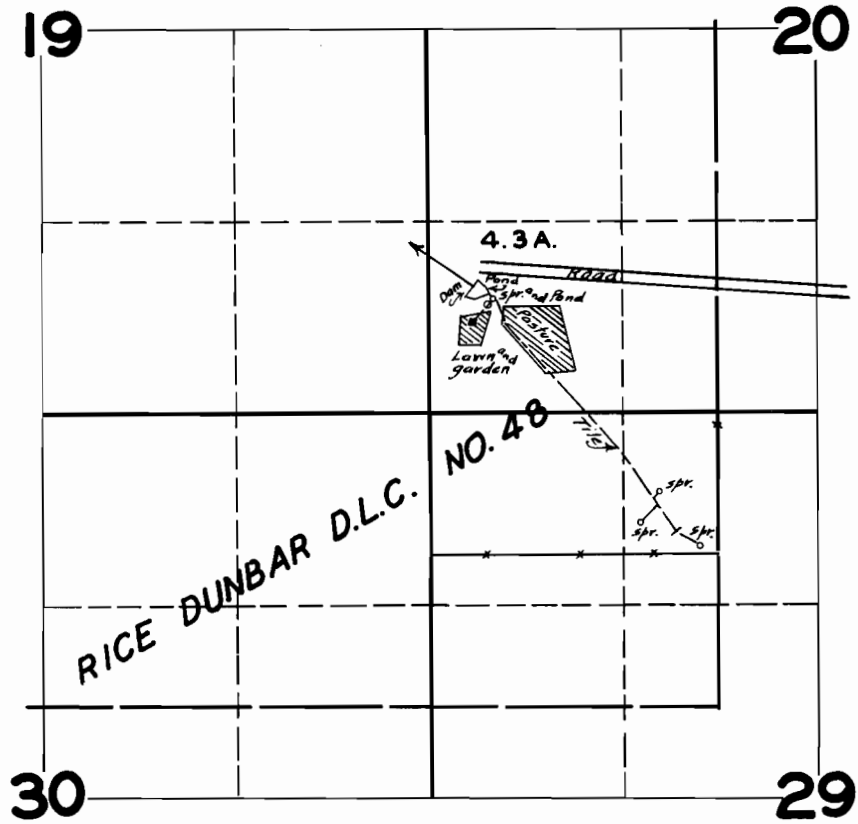

## FINAL PROOF SURVEY UNDER

Application No. 17602 Permit No. 13295

IN NAME OF

IDA M. EYRE

Surveyed JUN. 24 1947, by JAS. E. BUNNELL