


T.10S.R.7W.W.M.

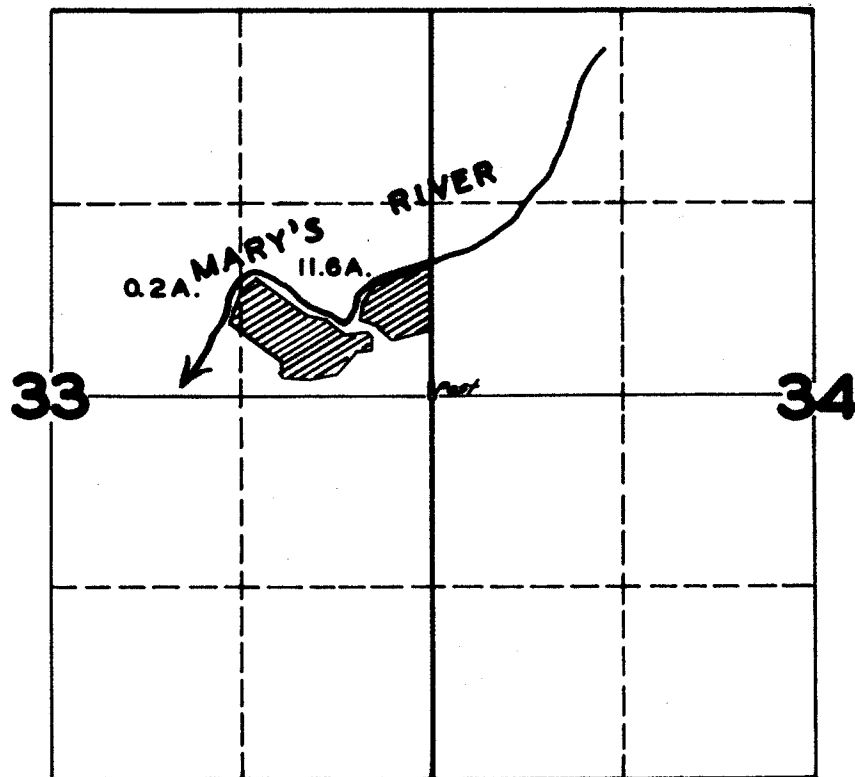

FINAL PROOF SURVEY
UNDER

Application No. 17662 Permit No. 13356
IN NAME OF

MR. & MRS. ORVA S. BAGLEY

Surveyed JULY 8 1948, by JAS. E. BUNNELL