


# T.5S.R.5W.W.M.

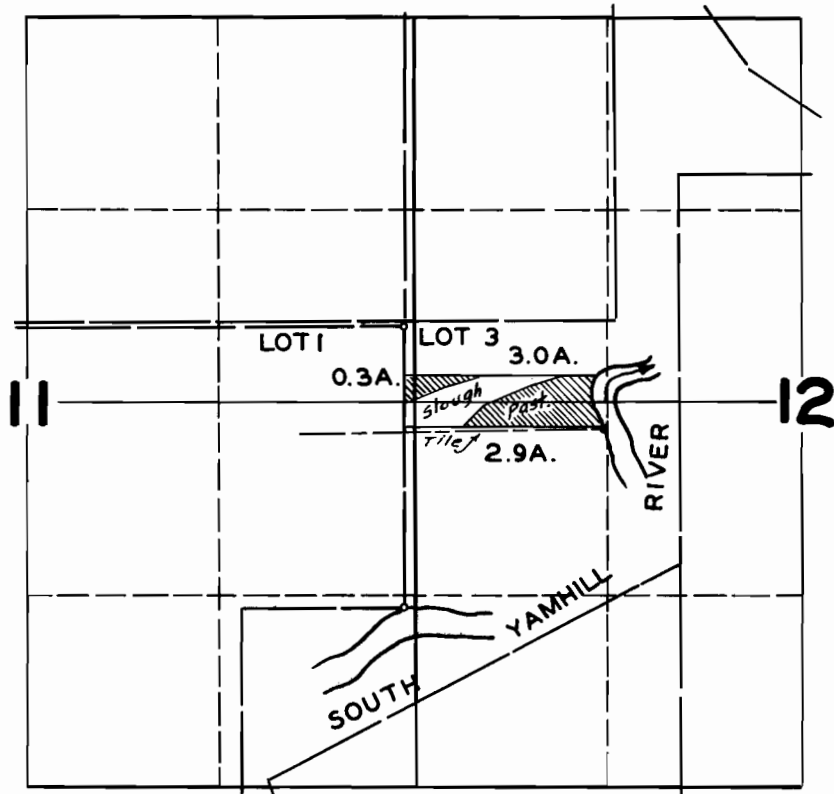

## FINAL PROOF SURVEY

UNDER

Application No. **17666** Permit No. **13360**

IN NAME OF

**RALPH HENRY BERGSTROM, BY CARL BERGSTROM**

Surveyed **MAR. 10 1948**, by **JAS. E. BUNNELL**