


T.5S.R.5W.W.M.

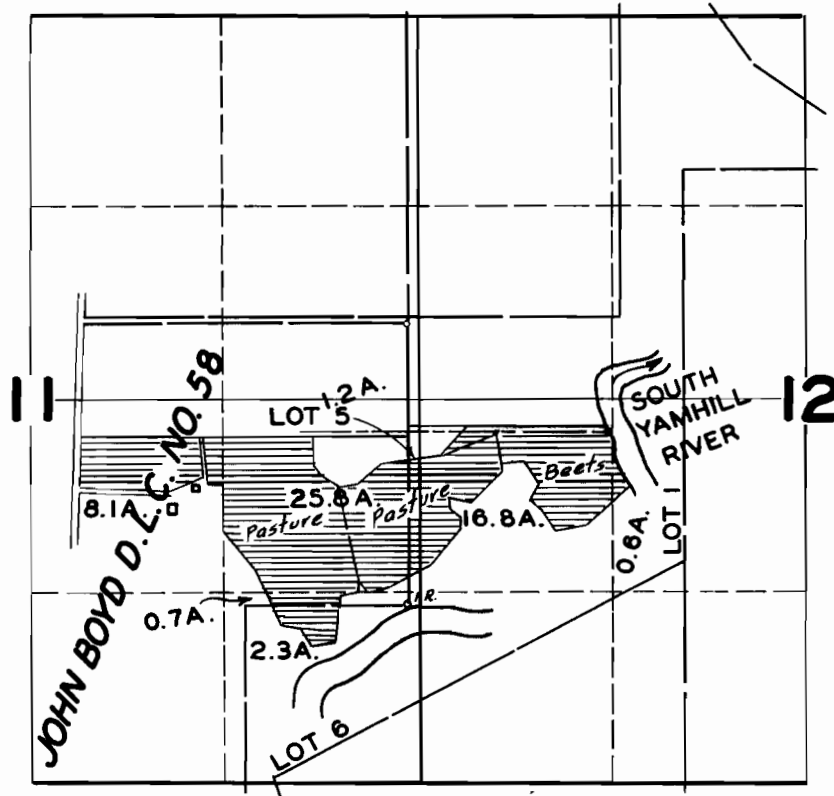

FINAL PROOF SURVEY

UNDER

Application No. **17667** Permit No. **13361**

IN NAME OF

MARIE BERGSTROM & RALPH HENRY BERGSTROM

Surveyed **MAR. 10 1948** by **JAS. E. BUNNELL**