


T.5S.R.5W.W.M.

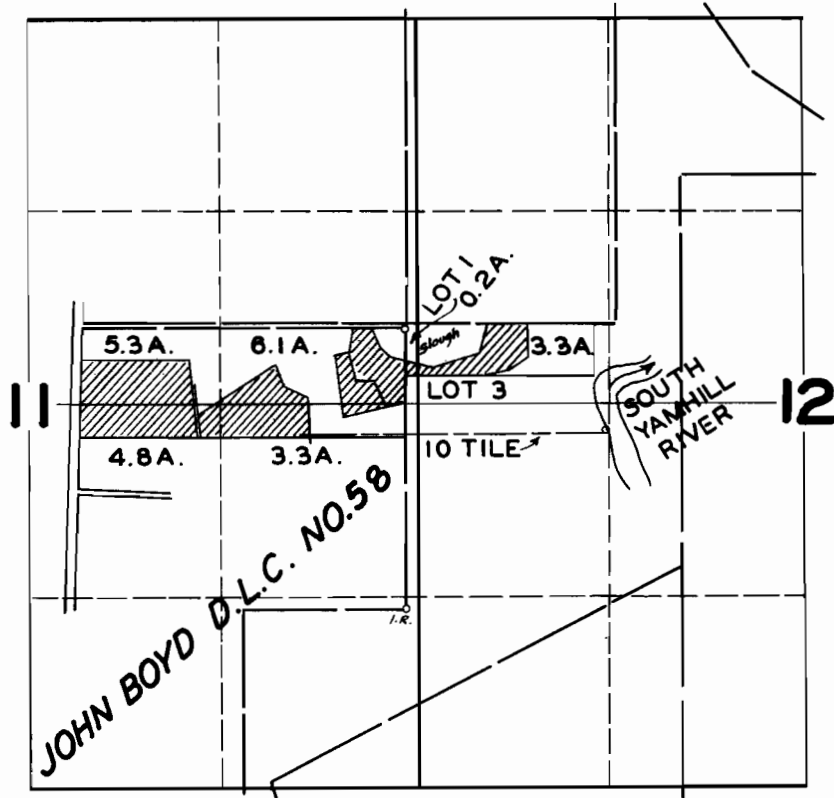

FINAL PROOF SURVEY UNDER

Application No. 17668 Permit No. 13362
IN NAME OF

CARL O. & MARIE BERG STROM

Surveyed MAR. 10, 1948, by JAS. E. BUNNELL