


T.4S.R.3W.W.M.

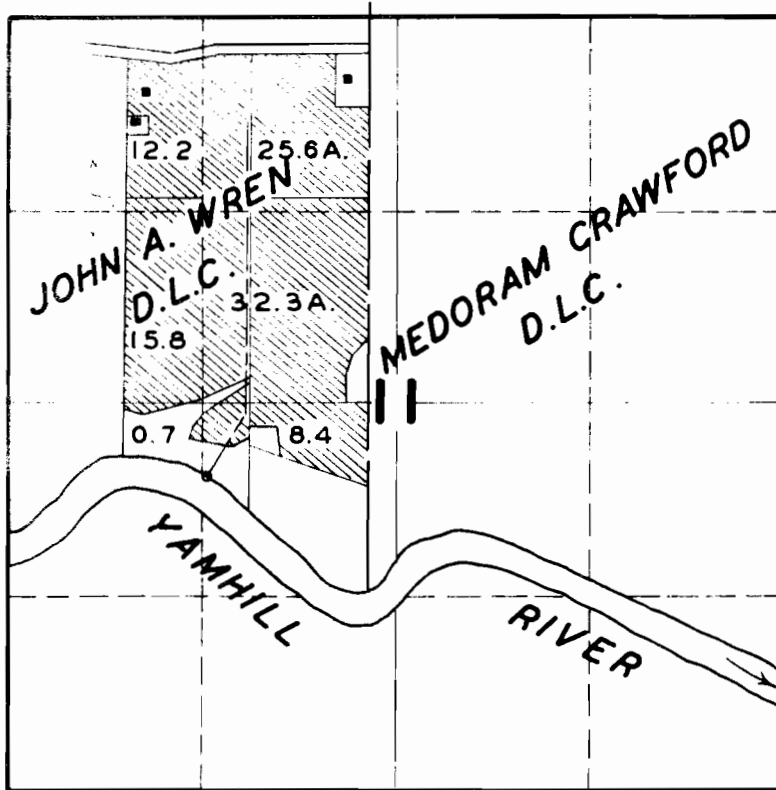

FINAL PROOF SURVEY

UNDER

17785

13466

Application No. 21917 Permit No. 17340

IN NAME OF

GUS A. WILSON

Surveyed APR. 15 1949 by JAS. E. BUNNELL