


Per. 13606
16633

T.10S. R. 33E. W. M.

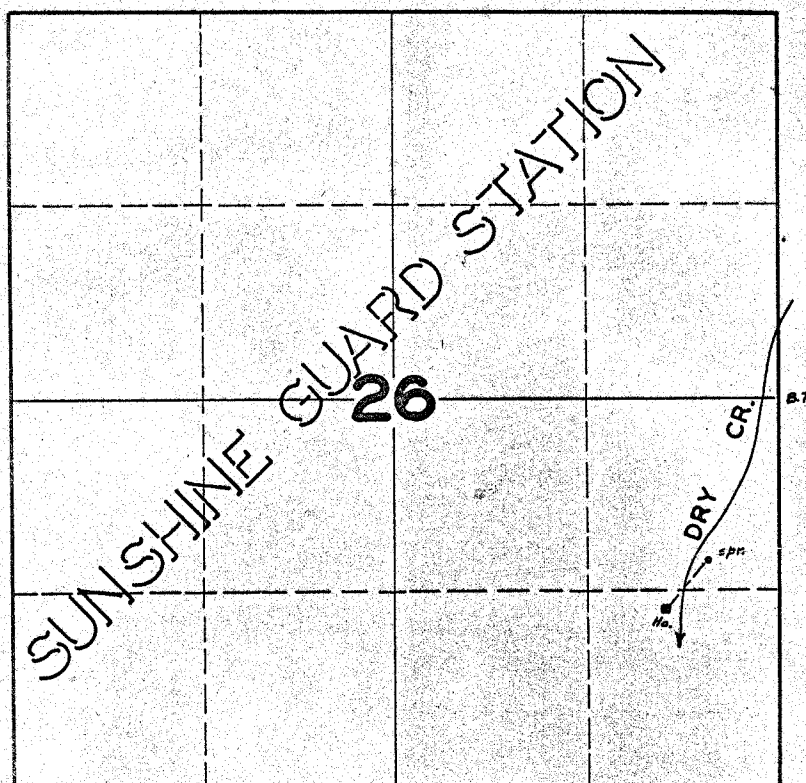

**FINAL PROOF SURVEY
UNDER**

Application No. 17920 Permit No. 13606

IN NAME OF

U. S. FOREST SERVICE - WHITMAN NATIONAL FOREST

Surveyed MAY 19 1947, by JAS. E. BUNNELL