


T.4S.R.3W.W.M.

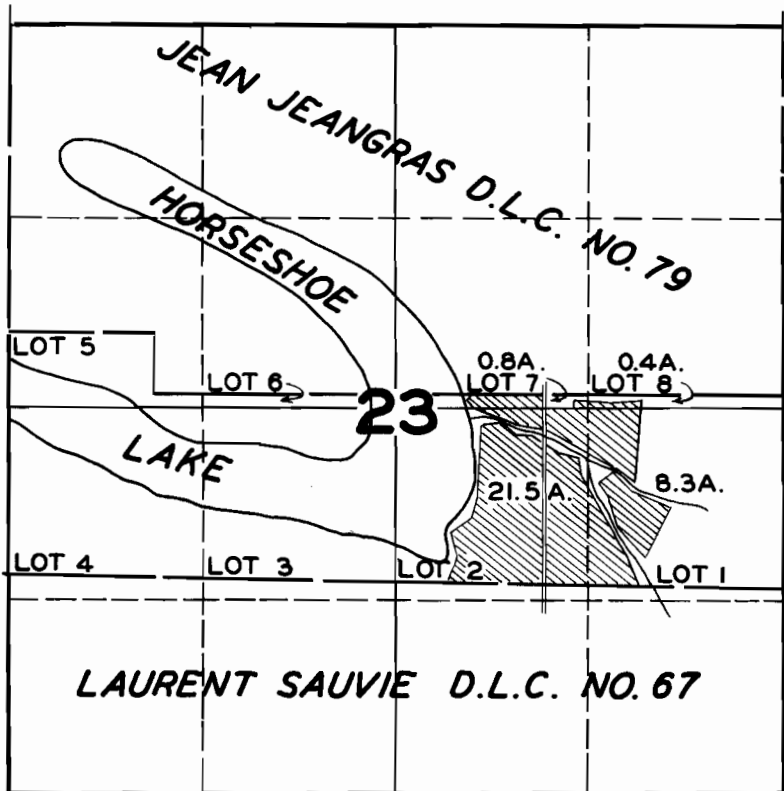

FINAL PROOF SURVEY
UNDER

Application No. **18149** Permit No. **13793**
IN NAME OF

L.L. ERNST

Surveyed **APR. 20, 1948**, by **JAS. E. BUNNELL**