


Per 14273
16635

T.12S. R.34E.W.M.

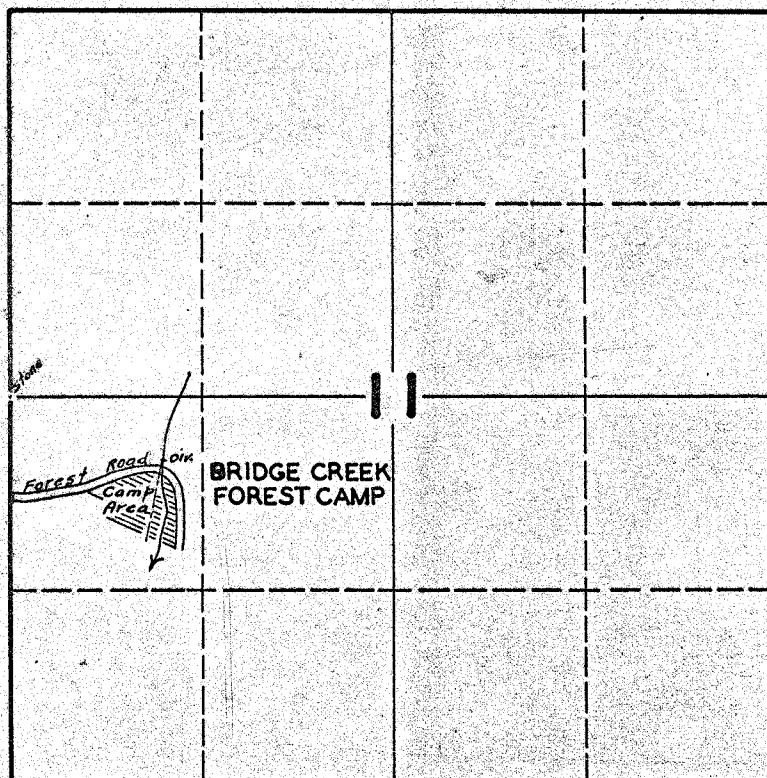

**FINAL PROOF SURVEY
UNDER**

Application No. 18638 Permit No. 14273

IN NAME OF

U.S. FOREST SERVICE - WHITMAN NATIONAL FOREST

Surveyed MAY 19, 1947, by JAS. E. BUNNELL