


T.3S.R.2W.W.M.

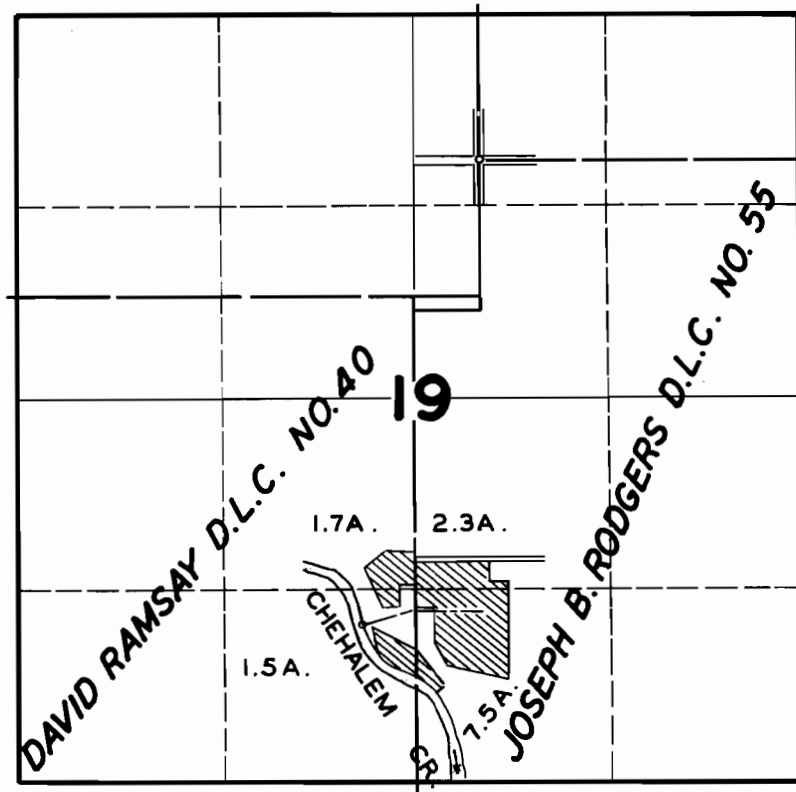

FINAL PROOF SURVEY UNDER

Application No. **16033** Permit No. **11855**
IN NAME OF

L. C. FRENCH

Surveyed **MAR. 31, 1947**, by **JAS. E. BUNNELL**